LABOR AND MATERIALS FOR A COMPLETE SYSTEM. ANY APPLIANCES OR MATERIALS OBVIOUSLY A PART OF THE SYSTEM AND NECESSARY FOR ITS PROPER OPERATION, ALTHOUGH NOT SPECIFICALLY MENTIONED HEREIN, SHALL BE FURNISHED AND INSTALLED AS IF CALLED FOR IN DETAIL. WORKMANSHIP AND MATERIALS SHALL BE IN ACCORDANCE WITH ALL STATE AND LOCAL CODES, NFPA 90A, AND THE BUILDING REGULATIONS. ATTAIN AND PAY FOR ALL REQUIRED PERMITS AND FEES. EQUIPMENT AND MATERIALS SHALL BE NEW UNLESS OTHERWISE SPECIFIED. MECHANICAL CONTRACTOR SHALL BE LICENSED TO HANDLE

DRAWINGS ARE GENERALLY DIAGRAMMATIC AND DO NOT NECESSARILY SHOW EVERY FITTING. OFFSET, DROP AND RISE OF RUNS, AND DETAIL. INSTALL DUCTS, EQUIPMENT, AND CONTROLS IN A NEAT, WORKMANLIKE MANNER AND IN ACCORDANCE WITH GOOD PRACTICE FOR A COMPLETE, WORKABLE INSTALLATION. AVOID CONFLICT WITH OTHER WORK; MAKE ADEQUATE PROVISIONS FOR PREVENTING NOISE AND VIBRATION. DRAWINGS INDICATE LOCATIONS OF FIXTURES, APPARATUS, DUCTWORK, AND PIPING; WHILE THESE ARE TO BE FOLLOWED AS CLOSELY AS POSSIBLE, IF IT IS NECESSARY TO CHANGE THE LOCATION OF SOME TO ACCOMMODATE BUILDING CONDITIONS, MAKE CHANGES WITHOUT ADDITIONAL COST TO THE OWNER AND AS APPROVED BY THE ARCHITECT. PROVIDE ADEQUATE ACCESS TO EQUIPMENT AND APPARATUS REQUIRING OPERATION, SERVICE, OR MAINTENANCE WITHIN THE LIFE OF THE SYSTEM. DO NOT RUN PIPING OR DUCTWORK, OR LOCATE EQUIPMENT (WITH RESPECT TO SWITCHBOARDS, PANEL BOARDS. POWER PANELS, MOTOR CONTROL CENTERS OR DRY TYPE TRANSFORMERS) WITHIN 42 INCHES IN FRONT OF EQUIPMENT, OVER EQUIPMENT, OR WITHIN 36 INCHES HORIZONTALLY OF SAME SPACE.

CONTRACTOR SHALL VISIT THE SITE AND FAMILIARIZE HIMSELF WITH THE JOB CONDITIONS BEFORE SUBMITTING HIS PROPOSAL. IT SHALL BE THE CONTRACTOR'S RESPONSIBILITY TO VERIFY LOCATIONS AND SIZES OF ALL EXISTING UTILITY SERVICES PRIOR TO SUBMITTING HIS PROPOSAL. NO CONSIDERATION WILL BE GIVEN TO CLAIMS FOR EXTRA COST ARISING FROM CONTRACTOR'S FAILURE TO BE FULLY COGNIZANT OF JOB OR SITE CONDITIONS EXISTING AT TIME OF ACCEPTANCE

IF, DURING THIS INSPECTION, THE CONTRACTOR FINDS ANY OBSTRUCTION OR INTERFERENCE THAT MAY PROHIBIT THE PROPER INSTALLATION OF HIS WORK, HE IS TO MAKE IT KNOWN TO THE BUILDING MANAGEMENT AND/OR OWNER AND TENANT BEFORE AND AT THE TIME OF SUBMITTING HIS PROPOSAL

BY SUBMISSION OF THE BID, IT IS UNDERSTOOD THAT SUCH INSPECTION HAS BEEN MADE AND INCLUDES ALL THE MATERIALS AND REQUIRED RELOCATION FOR ALL

ACTIVE SERVICES: WHEN ENCOUNTERED IN WORK, PROTECT, BRACE, OR SUPPORT EXISTING ACTIVE SEWERS, GAS, AND OTHER SERVICES REQUIRED FOR PROPER EXECUTION OF WORK. IF EXISTING ACTIVE SERVICES ARE ENCOUNTERED THAT REQUIRE RELOCATION, RELOCATE AS APPROVED. DO NOT PREVENT OR DISTURB OPERATION OF ACTIVE SERVICES THAT ARE TO REMAIN.

INACTIVE SERVICES: WHEN ENCOUNTERED IN WORK, REMOVE, CAP, OR PLUG INACTIVE SERVICES, AS INDICATED. OPENINGS IN THE DUCTWORK SHALL BE PATCHED WITH SHEET METAL, SEALED AIRTIGHT WITH DUCT SEALANT, AND RE-INSULATED.

INTERRUPTION OF SERVICES: WHERE WORK MAKES TEMPORARY SHUTDOWNS OF SERVICES UNAVOIDABLE, SHUT DOWN AT NIGHT, OR AT SUCH TIMES AS APPROVED BY OWNER AND THE BUILDING MANAGEMENT WHICH WILL CAUSE LEAST INTERFERENCE WITH ESTABLISHED OPERATING ROUTINE. ARRANGE WORK TO ASSURE THAT SERVICES WILL BE SHUT DOWN ONLY DURING TIME ACTUALLY REQUIRED TO MAKE NECESSARY CONNECTION TO EXISTING WORK.

WHERE EXISTING WALLS, CEILINGS, FLOORS, ETC., ARE CUT OR OTHERWISE DAMAGED DURING CONSTRUCTION, REPAIR ALL SURFACES TO THEIR ORIGINAL

COORDINATE ALL WORK UNDER THIS DIVISION WITH THE WORK UNDER OTHER DIVISIONS. PROVIDE ADJUSTMENTS AS NECESSARY. EQUIPMENT, APPARATUS, DUCTWORK, PIPING, ETC., INSTALLED WITHOUT REGARD FOR THE SPEC REQUIREMENTS OR OTHER TRADES WILL BE REWORKED AT THE EXPENSE OF THE INSTALLING SUBCONTRACTOR IF IT CREATES AN UNNECESSARY HINDRANCE TO THE INSTALLATION OF ANOTHER TRADE'S WORK. ALL ITEMS MOUNTED OR BELOW THE CEILING, AND ANY ITEM PENETRATING THE CEILING, SHALL BE COORDINATED WITH THE ARCHITECTURAL REFLECTED CEILING PLANS.

PROTECTION OF WORK DURING CONSTRUCTION PROVIDE PROTECTIVE COVERS, SKIDS, PLUGS OR CAPS TO PROTECT FOLIPMENT AND MATERIALS FROM DAMAGE AND DETERIORATION DURING CONSTRUCTION. PROTECT EXPOSED COILS WITH PLYWOOD OR OTHER SUITABLE RIGID COVERS TO

AVOID DAMAGE TO FINS. CONTRACTOR SHALL TAKE PRECAUTIONS AGAINST DAMAGING OR DISRUPTING BUILDING SYSTEMS, WIRING OR CONTROL TUBING FOR ADJACENT TENANTS. ANY DAMAGE SHALL BE REPAIRED AT THE CONTRACTOR'S COST.

PROTECT ALL EQUIPMENT AND MATERIALS FROM DAMAGE. ANY DAMAGE SHALL BE REPAIRED USING THE SAME MATERIALS AT THE CONTRACTOR'S COST.

TEST AND BALANCE HVAC AIR SYSTEMS TO WITHIN +10%, -5% OF DESIGN FLOW. CHECK ALL FANS, INSTRUMENTATION DEVICES, CONTROL DEVICES, DAMPERS, ETC., FOR PROPER OPERATION AND CALIBRATION. REPORT DEFICIENCIES THAT CANNOT BE CORRECTED. MARK AND LOCK DAMPER AT THEIR PROPER POSITION. ADJUST FANS FOR THE CFM SHOWN ON THE FLOOR PLAN.

ADJUST, TEST AND CONFIRM DESIGN AIR FLOW RATES, PRESSURES, TEMPERATURES, AIR QUANTITIES, EQUIPMENT SPEED, AND MOTOR AMPERAGES FOR EACH SEGMENT BRANCH AND COMPONENT OF EACH SYSTEM.

VERIFY THAT DIFFUSER DISCHARGE PATTERNS HAVE BEEN PROPERLY SET. AIR FLOWS SHALL BE BALANCED WITH THE VOLUME DAMPERS INSTALLED IN BRANCH DUCTWORK. OPPOSED BLADE DAMPERS (OBD) IN THE DIFFUSERS SHALL BE SET IN THE FULLY OPEN POSITION DURING BALANCING. AFTER THE MAIN SYSTEM IS BALANCED WITHIN LIMITS SPECIFIED ABOVE, OBD CAN BE USED FOR MINOR

SET MAXIMUM AND MINIMUM CFM. SET POINTS ON ALL NEW AND EXISTING VAV BOXES AND POWER INDUCTION UNITS (PIU) PER DESIGN CFM NOTED ON PLANS. DETERMINE REQUIRED MINIMUM STATIC PRESSURE SET POINT OF BASE BUILDING AIR HANDLING UNIT(S) TO ENSURE THAT DESIGN ARE ATTAINED. INFORM BUILDING OPERATOR OF THIS REQUIRED SETTING.

ADJUSTMENTS AND TESTS SHALL BE MADE UNDER SIMULATED MAXIMUM LOAD

THE MECHANICAL CONTRACTOR SHALL PERFORM THE TEST AND PROVIDE REPORT(S) FOR REVIEW TO THE ARCHITECT/ENGINEER AT THE COMPLETION OF THE JOB. WORK SHALL BE PERFORMED AND FORM SUBMITTED IN ACCORDANCE WITH THE GUIDELINES ON ASSOCIATED AIR BALANCE COUNCIL (AABC) OR NATIONAL ENVIRONMENTAL BALANCING BUREAU (NEBB).

THE TEST AND BALANCE AGENCY SHALL PROVIDE EQUIPMENT, PERSONNEL, AND A COPY OF THE TEST AND BALANCE REPORT AT THE ENGINEER'S FINAL INSPECTION FOR SPOT-CHECKING. ANY SYSTEM FOUND IMPROPERLY BALANCED OR NOT IN AGREEMENT WITH THE REPORT SHALL BE RE-BALANCED AND A REVISED REPORT

THE TEST AND BALANCE AGENCY SHALL PERFORM A "COMFORT" BALANCE 45 DAYS AFTER TENANT MOVES IN.

UPON COMPLETION OF PROJECT, THE CONTRACTOR SHALL PROVIDE A COMPLETE SET OF REPRODUCIBLE DRAWINGS REFLECTING THE "AS BUILT" CONDITION OF THE

OPERATING AND MAINTENANCE MANUALS MECHANICAL CONTRACTOR SHALL SUBMIT OPERATING AND MAINTENANCE MANUALS UPON COMPLETION OF THE PROJECT. MANUALS TO BE IN ACCORDANCE WITH SECTION 503.2.9.2 OF THE CURRENT LOCALLY ADOPTED ENERGY CONSERVATION

**GUARANTEE** MATERIALS AND WORKMANSHIP SHALL BE GUARANTEED AGAINST DEFECTS FOR ONE YEAR. PROVIDE ADDITIONAL FOUR YEARS WARRANTY ON ALL COMPRESSORS.

SLEEVES SHALL BE PROVIDED WHERE PIPES PASS THROUGH WALLS, FLOORS, AND ROOFS: IRON PIPES PASSING THROUGH MASONRY WALL MAY BE BUILT INTO THE WALL. SLEEVES SHALL BE STANDARD WEIGHT STEEL PIPE, EXCEPT SLEEVES FOR CONCEALED PIPING THROUGH FLOORS NOT IN STRUCTURAL MEMBERS: THEY MAY BE 25 GAUGE GALVANIZED SHEET METAL. FLOOR SLEEVES FOR PIPING SHALL EXTEND FROM THE BOTTOM OF THE SLAB TO 2 INCHES ABOVE THE FINISHED FLOOR. WALL SLEEVES SHALL BE FULL THICKNESS OF WALLS. SEAL BETWEEN PIPING AND SLEEVE WITH FIRE-RATED CAULK AT ALL PENETRATIONS OF FIRE-RATED WALLS, PARTITIONS OR FLOORS. MAKE SLEEVES THROUGH OUTSIDE WALLS WATERTIGHT. CAULK BETWEEN UN-INSULATED PIPE AND SLEEVE. SIZE SLEEVES FOR INSULATED PIPES TO ALLOW FULL THICKNESS INSULATION.

ALL ELECTRICAL WORK AND INSTALLATION PROVIDED UNDER THIS DIVISION SHALL COMPLY WITH THE NATIONAL ELECTRICAL CODE AND THE REQUIREMENTS OF DIVISION 16. ALL POWER WIRING AND FINAL POWER CONNECTIONS TO THE SYSTEM SHALL BE PROVIDED UNDER DIVISION 16. CONTROL WIRING (120V AND LESS) SHALL BE PROVIDED UNDER DIVISION 15 AND EXTENDED FROM THE 120V POWER CIRCUITS INDICATED ON THE ELECTRICAL DRAWINGS. ALL WIRING FOR VOLTAGES HIGHER THAN 30 VOLTS SHALL BE DONE BY A LICENSED ELECTRICIAN. ALL ELECTRICAL CHARACTERISTICS SHALL BE TAKEN FROM THE ELECTRICAL DRAWINGS AND SPECIFICATIONS AND COORDINATED BEFORE EQUIPMENT IS ORDERED OR SUBMITTED. ALL WIRING IN THE CEILING PLENUM SHALL BE PLENUM-RATED CABLE OR IN CONDUIT.

MOTORS AND STARTERS PROVIDE MOTORS, STARTERS, PUSH BUTTONS, THERMAL OVERLOAD SWITCHES, AND CONTACTORS FOR EQUIPMENT COVERED HEREIN, UNLESS OTHERWISE SPECIFIED. INSTALLATION OF STARTERS, PUSH BUTTONS, THERMAL OVERLOAD SWITCHES, AND CONTACTORS (NOT FACTORY-INSTALLED) IS SPECIFIED UNDER

UNLESS OTHERWISE SPECIFIED, PROVIDE EACH MOTOR 1/2 HP AND LARGER WITH A MAGNETIC STARTER PROVIDING OVERLOAD AND LOW VOLTAGE PROTECTION. PROVIDE A CONTROL VOLTAGE TRANSFORMER IN EACH STARTER.

A HAND-OFF-AUTO SWITCH WITH PILOT LIGHT SHALL BE MOUNTED ON THE FACE OF EACH STARTER.

PROVIDE LABELS FOR EACH EQUIPMENT, STARTER, AND CONTROL SWITCH. LABELS TO BE ENGRAVED, LAMINATED, BAKELITE NAMEPLATES WITH 1/4 INCH HIGH WHITE CUT LETTERS; SECURE TO STARTER OR SWITCH.

EQUIPMENT, MATERIALS AND BID BASIS SPECIFIED MANUFACTURER'S NAMES AND MODEL NUMBERS ARE FOR THE PURPOSE OF DESCRIBING TYPE, CAPACITY, FUNCTION, AND QUALITY OF EQUIPMENT AND MATERIALS TO BE USED. UNLESS "OR EQUAL" OR SPECIFICALLY STATED, BIDS SHALL BE BASED ON EQUIPMENT NAMES. CAPACITIES INDICATED TAKE PRECEDENCE OVER MODEL NUMBERS.

SUPPORT ALL CEILING-MOUNTED EQUIPMENT, DUCTWORK, AND PIPING FROM BUILDING STRUCTURE AND/OR FRAMING IN AN APPROVED MANNER. WHERE OVERHEAD CONSTRUCTION DOES NOT PERMIT FASTENING OF SUPPORTS AND EQUIPMENT, PROVIDE ADDITIONAL STEEL FRAMING. THIS CONTRACTOR SHALL COORDINATE SUPPORTS WITH THE BUILDING MANAGEMENT AND SUBMIT THE METHOD OF SUPPORT FOR REVIEW TO THE

OPENINGS THROUGH ROOF PROVIDE ALL NECESSARY FLASHING AND COUNTER FLASHING TO MAINTAIN THE WATERPROOF INTEGRITY OF THIS BUILDING AS REQUIRED BY THE REMOVAL

AND/OR INSTALLATION OF PIPES, DUCTS, CONDUITS, AND EQUIPMENT. SUBMIT FOR REVIEW TO THE BUILDING MANAGEMENT. VIBRATION ISOLATORS VIBRATION ISOLATORS FOR FANS SHALL BE THE HANGER TYPE AND SHALL CONTAIN A STEEL SPRING AND 0.3" DEFLECTION NEOPRENE ELEMENT IN SERIES.

THE NEOPRENE ELEMENT SHALL BE MOLDED WITH A ROD ISOLATION BUSHING

THAT PASSES THROUGH THE HANGER BOX. SPRING DIAMETERS AND HANGER BOX LOWER HOLE SIZES SHALL BE LARGE ENOUGH TO PERMIT THE HANGER ROD TO SWING THROUGH A 15 DEGREE ARC BEFORE CONTACTING THE HOLE AND SHORT CIRCUITING THE SPRING. SPRINGS SHALL HAVE A MINIMUM ADDITIONAL TRAVEL TO SOLID HEIGHT EQUAL TO 50% OF

SUSPENDED EQUIPMENT SHALL BE PROVIDED WITH VIBRATION ISOLATION HANGERS WHICH SHALL BE FURNISHED WITH THE UNIT, AND ISOLATOR SHALL BE MATCHED TO EQUIPMENT WEIGHT AND SUPPORT LOCATIONS. ISOLATION HANGERS SHALL BE COMBINATION STEEL SPRING AND NEOPRENE-IN-SHEAR WITH STEEL HOUSING. ISOLATORS SHALL HAVE A MINIMUM OPERATING DEFLECTION OF 1 1/2". SPRINGS SHALL HAVE A MINIMUM ADDITIONAL TRAVEL FOR 50% BETWEEN THE DESIGN

HEIGHT AND THE SOLID HEIGHT.

BUILDING MANAGEMENT.

QUALITY ASSURANCE: SPECIFIED COMPONENTS OF THIS INSULATION SYSTEM. INCLUDING FACINGS, MASTICS AND ADHESIVES, SHALL HAVE A FIRE HAZARD RATING NOT TO EXCEED 25 FOR FLAME SPREAD AND 50 FOR SMOKE DEVELOPED RATING, AS PER TESTS CONDUCTED IN ACCORDANCE WITH ASTM E84 (NFPA 255)

PIPE INSULATION: TYPE P1 ASTM C547, CLASS 1 (-20 DEGREES F TO 500 DEGREES F): FIBERGLASS, MINIMUM 4 POUNDS PER CUBIC FOOT (P.C.F.) DENSITY, K FACTOR 0.23 MAXIMUM AT 75 DEGREES F MEAN. WITH FACTORY-APPLIED ALL-SERVICE-JACKET (ASJ) COMPOSED OF REINFORCED KRAFT AND ALUMINUM FOIL LAMINATE. JACKET SHALL HAVE SELF-SEALING LAP TO FACILITATE CLOSING LONGITUDINAL AND APPROVED PRODUCTS: CERTAINED 500 DEGREE SNAP-ON ASJ/SSL MANVILLE MICRO-LOK AP-T OWENS/CORNING FIBERGLASS 25 ASJ/SSL KNAUF PIPE INSULATION ASJ/SSL

TYPE P2 ASTM C534 (-40 DEGREES F TO 220 DEGREES F:) FLEXIBLE, CLOSED-CELL ELASTOMERIC, NOMINAL 6 PCF DENSITY, K FACTOR 0.27 MAXIMUM AT 75 DEGREES F MEAN.

APPROVED PRODUCTS: ARMSTRONG AP ARMAFLEX MANVILLE AEROTUBE II NOMACO THERMA-CEL RUBATEX R-180-F5

DUCT INSULATION: TYPE D1 ASTM C553 TYPE 1, CLASS B3:
FIBERGLASS, NOMINAL 1 P.C.F. DENSITY BLANKET, K FACTOR 0.31 MAXIMUM AT 75 DEGREES F MEAN. WITH FACTORY APPLIED FSK (FOIL-SCRIM-KRAFT) VAPOR BARRIER JACKET, FOR TEMPERATURES TO TEMPERATURES 250 DEGREES F.

APPROVED PRODUCTS: CERTAINED "STANDARD DUCT WRAP" MANVILLE "MICROLITE" OWENS/CORNING FIBERGLASS RFK-75 KNAUF "DUCTWRAP"

FIBERGLASS, NOMINAL 2.0 P.C.F. DENSITY LINER, K FACTOR 0.26 MAXIMUM AT 75 DEGREES F MEAN, BLACK COATING, FOR

APPROVED PRODUCTS: CERTAINED ULTRALITE DUCT LINER 200 MANVILLE LINACOUSTIC KNAUF DUCT LINER M

INSTALLATION OF PIPE INSULATION: INSTALL INSULATION ON PIPE SYSTEMS SUBSEQUENT TO TESTING AND ACCEPTANCE OF TEST.

MAINTAIN INTEGRITY OF VAPOR-BARRIER JACKETS ON PIPE INSULATION, AND PROTECT TO PREVENT PUNCTURE OR OTHER DAMAGE. SEAL OPEN ENDS OF INSULATION WITH MASTIC. SECTIONALLY SEAL ALL BUTT ENDS OF ALL COLD WATER PIPING INSULATION AT FITTINGS WITH WHITE VAPOR BARRIER COATING.

COVER VALVES, FLANGES, FITTINGS, AND SIMILAR ITEMS IN EACH PIPING SYSTEM WITH EQUIVALENT THICKNESS AND COMPOSITION OF INSULATION AS APPLIED TO ADJOINING PIPE RUN. INSTALL FACTORY MOLDED, PRECUT OR JOB FABRICATED UNITS (AT INSTALLER'S OPTION). FINISH COLD PIPE FITTINGS WITH WHITE VAPOR BARRIER COATING AND HOT PIPING WITH WHITE VINYL ACRYLIC MASTIC, BOTH REINFORCED WITH GLASS CLOTH.

FLOORS AND SIMILAR PIPING PENETRATIONS, EXCEPT WHERE OTHERWISE

EXTEND PIPING INSULATION WITHOUT INTERRUPTION THROUGH WALLS,

INSTALL PROTECTIVE METAL SHIELDS AND FOAM GLASS INSERTS WHERE PIPE HANGERS BEAR ON OUTSIDE ON INSULATION.

INSTALLATION OF DUCTWORK INSULATION: MAINTAIN INTEGRITY OF VAPOR-BARRIER ON DUCTWORK INSULATION. AND PROTECT IT TO PREVENT PUNCTURE AND OTHER DAMAGE. TAPE ALL PUNCTURES. SECURE ALL DUCTWORK WITH GALVANIZED WIRE 12' O.C. SECURE DUCTWORK WITH OUTWARD CLINCHING STAPLES. SEAL ALL LONGITUDINAL AND CIRCUMFERENTIAL JOINTS WITH FSK TAPE.

OTHERWISE INDICATED. EXCEPT AS OTHERWISE INDICATED, OMIT INSULATION ON DUCTWORK WHERE INTERNAL INSULATION OR SOUND ABSORBING LININGS HAVE

FLOORS, AND SIMILAR DUCTWORK PENETRATIONS, EXCEPT WHERE

EXTEND DUCTWORK INSULATION WITHOUT INTERRUPTION THROUGH WALLS,

ALL INTERNAL INSULATION SHALL BE ADHERED TO THE DUCT WITH 100% COVERAGE OF APPROVED FIRE RETARDANT MASTIC. ALL EDGES SHALL BE SEALED. ANY ABRASIONS OR TEARS REPAIRED WITH MASTIC. INCREASE INDICATED DUCT SIZES TO COMPENSATE FOR LINER

INSULATION REQUIREMENTS:

THICKNESS.

BEEN INSTALLED.

INSULATION SCHEDULE

LOCATION	WRAP	WRAP SIZE (IN.)	WRAP TYPE	WRAP R-VAL	LINER	LINER SIZE (IN.)	LINER LOCATION	LINER TYPE	LINER R-VA
INDOOR CONCEALED SA/RA	X	2"	D1	6.0	X	1"	FIRST 10' FROM UNIT	SEE S	SINGLE
INDOOR EXPOSED SA/RA		-	_	-	$\boxtimes$	1"	CONTINUOUS		SPEC SHEE
OUTDOOR CONCEALED SA/RA	X	2"	D1	8.0	$\boxtimes$	2"	CONTINUOUS	D3	8.0
OUTDOOR EXPOSED SA/RA		_	_	-		-	-	_	-
INDOOR CONCEALED OA	X	2"	D1	6.0		<b>-</b>	-	-	-
INDOOR EXPOSED OA		_	_	ı		1	_	_	_
INDOOR EA		_	-	1		ı	-	_	_
INDOOR TRANSFER		_	-	1		1"	CONTINUOUS	D3	4.2
TYPE I KITCHEN EA		_	-	1		-	_	_	_
REFRIGERANT PIPING	X	1/2"	P1	CODE MIN.		-	_	_	-
CONDENSATE PIPING		_	_	_			_	_	_

MAINTENANCE AND SERVICE THIS CONTRACTOR SHALL INCLUDE AND ASSUME COMPLETE RESPONSIBILITY FOR START-UP, 24 HOURS A DAY SERVICE WITH A RESPONSE TIME NOT TO EXCEED FOUR (4) HOURS.

MAINTENANCE ON A QUARTERLY BASIS (FOUR MAINTENANCE INSPECTIONS A YEAR) FOR A PERIOD OF ONE YEAR FOR ALL HVAC EQUIPMENT, INCLUDING PRE PURCHASED EQUIPMENT AS IS SAID PRE PURCHASED EQUIPMENT WERE PURCHASED BY THIS CONTRACTOR, AND INCLUDING EXISTING EQUIPMENT WITHIN TENANT SPACE. PROVIDE COST TO PERFORM PREVENTATIVE MAINTENANCE FOR THE FIRST YEAR ONLY. THIS ONE-YEAR MAINTENANCE CONTRACT SHALL INCLUDE, BUT IS NOT LIMITED TO THE FOLLOWING WORK: CHECK LINES FOR LEAKAGE OF REFRIGERANT/WATER

REFILL LINES IF NECESSARY LUBRICATE MOTORS CHECK OPERATION OF THERMOSTATS REPLACE RETURN AIR FILTERS

SHALL BE SEAL CLASS "A".

CLEAN CONDENSER COILS CHECK AND TIGHTEN ELECTRICAL CONNECTIONS CHECK CONTROLS CHECK FOR NOISE AND VIBRATION

CHECK REFRIGERANT PRESSURE DURING OPERATION CHECK CURRENT (AMPERAGE) DRAW OF ALL MOTORS CHECK OPERATION OF CONDENSATE DRAIN SYSTEM CHECK AND ADJUST BLOWER FAN BELT TENSION

SHEET METAL WORK EXCEPT AS OTHERWISE NOTED. ALL DUCTWORK AND OTHER SHEET METAL WORK SHALL BE INSTALLED IN ACCORDANCE WITH LATEST EDITION OF THE SHEET METAL AND AIR CONDITIONING CONTRACTOR NATIONAL ASSOCIATION. INC. (SMACNA), HVAC CONSTRUCTION STANDARDS MANUAL. DUCTWORK SHALL BE GALVANIZED SHEET STEEL, UNLESS OTHERWISE NOTED. FIBERGLASS DUCTWORK IS NOT ACCEPTABLE.

MINIMUM DUCTWORK STATIC PRESSURE CONSTRUCTION SHALL BE 2" W.G. DUCTWORK STATIC PRESSURE CONSTRUCTION SHALL BE 4" W.G. FOR OPERATING PRESSURES ABOVE 2" W.G. AND UP TO 4" W.G. ALL DUCTS

LOW PRESSURE FLEXIBLE DUCT SHALL BE SIMILAR TO FLEX MASTER TYPE 5, OR APPROVED EQUAL, WITH 1" THICK INSULATION AND SHALL CONFORM TO U.L. 181 AND NFPA BULLETIN 90A.

TERMINAL UNITS TO BE THERMAFLEX 11 TYPE ST-L OR APPROVED EQUAL. FIRE DAMPERS: FIRE DAMPERS SHALL BE DYNAMIC TYPE SIMILAR TO RUSKIN CURTAINTYPE DIBD2. WITH BLADES OUTSIDE AIR STREAM, GALVANIZED STEEL CONSTRUCTION, EQUIPPED WITH FUSIBLE LINK, U.L. LISTED AND INSTALLED IN CONFORMANCE WITH U.L. AND NFPA STANDARD 90A, AND APPROVED FOR

USE BY AUTHORITIES HAVING JURISDICTION. PROVIDE ACCESS DOOR IN

MEDIUM PRESSURE FLEXIBLE DUCT TAKE-OFFS TO VARIABLE VOLUME

DUCTWORK FOR EACH FIRE DAMPER. VOLUME DAMPERS: SAME MATERIAL AS DUCT, PER SMACNA, EXCEPT PROVIDE BEARING AT ONE END OF DAMPER ROD AND QUADRANT WITH LEVER AND LOCK SCREW AT OTHER END. FOR INSULATED DUCTS, QUADRANTS MOUNTED ON COLLAR SHALL CLEAR INSULATION; INSTALL WITH LEVERS ACCESSIBLE OUTSIDE INSULATION. BALANCING DAMPERS SHALL BE THE

PROVIDE AND INSTALL INSULATED HINGED ACCESS PANELS FOR ALL FIRE AND COMBINATION FIRE/SMOKE DAMPERS.

FLEXIBLE CONNECTIONS: NEOPRENE-COATED GLASS FABRIC, 30 OZ. PER SQUARE YARD WITH SEWED AND CEMENTED SEAMS, SIMILAR TO VENT FABRICS. PROVIDE FLEXIBLE CONNECTIONS BETWEEN ALL EQUIPMENT AND RIGID DUCTWORK. FABRIC CONNECTIONS SHALL BE AT LEAST FOUR (4) INCHES LONG AND HAVE METAL COLLAR AT EACH END; ALLOW AT LEAST 1" SLACK TO ELIMINATE VIBRATION TRANSMISSION.

TURNING VANES: GALVANIZED STEEL, SINGLE THICKNESS VANES WITH MINIMUM TWO (2) INCHES INSIDE RADIUS. ALL SQUARE ELBOWS SHALL HAVE

TURNING VANES. ACCESS TILE IDENTIFICATIONS: PROVIDE BUTTONS, TABS, AND MARKERS TO IDENTIFY LOCATION OF ALL CONCEALED VALVES, DAMPERS, AND EQUIPMENT. SUBMIT TO ARCHITECT FOR APPROVAL

DUCT SIZES SHOWN ARE CLEAR INSIDE DIMENSIONS. WHERE INTERNAL INSULATION IS CALLED FOR, DIMENSIONS SHALL BE INCREASED BY THICKNESS

PORTIONS OF DUCTWORK VISIBLE THROUGH SUPPLY AND RETURN AIR OPENINGS SHALL BE PAINTED FLAT BLACK.

TRANSITION RECTANGULAR DUCTWORK ON THE BOTTOM AND SIDES. MAINTAIN DUCTWORK LEVEL AND AS HIGH AS POSSIBLE UNLESS NOTED OTHERWISE. FLEXIBLE DUCT RUNOUTS TO ALL PIUS, VAVS, AND DIFFUSERS SHALL BE INSTALLED FREE OF KINKS AND SAGS. ALL BRANCH DUCTWORK SHALL BE SIZED TO MATCH THE INLET OF THE PIU. VAV AND DIFFUSERS SERVED.

FLEXIBLE DUCT SHALL NOT BE ANY LONGER THAN 6 FEET ALL DUCT TRANSITIONS FROM SQUARE TO ROUND SHALL BE SMOOTH SQUARE TO ROUND TRANSITIONS. SPIN-IN FITTINGS AT THE END OF CAPPED DUCTS ARE NOT ACCEPTEPTABLE

ALL OPEN ENDED DUCTS SHALL BE REINFORCED WITH 1/2" x 1/2" THE EXTERIOR PERIMETER OF THE DUCT.

ALL SUPPLY DUCTWORK BETWEEN AIR HANDLING UNITS AND VAVS AND PIUS TO BE CONSIDERED AS HIGH VELOCITY, MEDIUM PRESSURE DUCTWORK. FOR ROUND DUCT TAKE-OFFS FROM METAL DUCTS, USE GENFLEX MODEL NUMBER SM-1DEL "SPIN-IN" FITTING.

GENERAL: PIPING SHALL BE COMPLETE WITH PIPE FITTINGS. VALVES. COUPLING, STRAINERS, HANGER RODS, HANGERS, SUPPORTS, GUIDES, SLEEVES, AND ACCESSORIES IN CONFORMANCE WITH THE LATEST CODES AND ASME, ANSI, ASTM AND MSS STANDARDS.

NO PIPING SHALL BE LESS THAN 3/4", UNLESS OTHERWISE

FOR PIPE SIZES NOT INDICATED ON PLANS, SEE MANUFACTURER'S EQUIPMENT CONNECTION DETAILS. PROVIDE FITTINGS FOR CHANGE IN PIPE SIZE AND FOR FINAL CONNECTION AT EQUIPMENT, AS REQUIRED. AVOID ENTRY OF FOREIGN MATTER INTO PIPING DURING

PROVIDE MINIMUM PITCH TO INSURE ADEQUATE VENTING AND

PIPING SUPPORTS:

HORIZONTAL PIPING AND PIPING HANGERS SHALL BE ADJUSTABLE CLEVIS TYPE "CARPENTER AND PATTERSON" FIGURE NUMBER 100 OR 100SH, OR APPROVAL EQUAL. HANGER RODS SHALL BE ON THE FOLLOWING DIAMETER:

PIPE SIZE: 1/4" & BELOW; ROD DIAMETER: 3/8"; MAX SPACING: 6' PIPE SIZE: 1/2" & 2": ROD DIAMETER: 38": MAX SPACING: 8'

PROVIDE ADDITIONAL SUPPORTS AT CHANGE OF DIRECTION. RUNOUTS. AND CONCENTRATED LOADS DUE TO VALVES, ETC.

REFRIGERANT PIPING SHALL BE COPPER ASTM #B280, FACTORY CLEANED, NITROGEN CHARGED, AND CAPPED.

CONDENSATE DISCHARGE PIPING AND FITTINGS SHALL BE COPPER TYPE "L" PIPE. SCHEDULE 40 PVC SHALL BE ACCEPTABLE FOR PIPE INSTALLED ON ROOF

HUMIDIFIER MAKE-UP WATER PIPING SHALL BE COPPER TYPE

PIPING AND FITTINGS SHALL BE SUITABLE FOR OPERATING PRESSURES OF 150 PSI.

PROVIDE DIELECTRIC GASKETS FOR JOINTS OF DISSIMILAR METALS: ISOLATING GASKETS, SLEEVES AND WASHERS BETWEEN FLANGES,

FOR MANUAL AIR VENTS, PROVIDE LINE SIZE AIR CHAMBER WITH 1/2" VALVE. PROVIDE VALVES AT ALL HIGH POINTS AND WHERE FLOW

TRAP SEAL IN CONDENSATE DRAIN PIPING SHALL BE MINIMUM 1" GREATER THAN THE STATIC PRESSURE IN SYSTEM. CITY WATER PIPING FOR HUMIDIFIER MAKE-UP AND CONDENSATE DISCHARGE PIPING: 95-5 TIN-ANTIMONY SOLDER JOINT

CHANGES FROM HORIZONTAL TO DOWNWARD.

CONNECTIONS--NO LEAD.

VALVES FOR WATER PIPING SHALL BE SUITABLE FOR THE SERVICE PRESSURE AND TEMPERATURE AND SHALL BE:

GLOBE VALVE: "JENKINS" FIGURE 556P, FIGURE 1200, FIGURE 613-C, OR FIGURE 923-C, OR APPROVED EQUAL.

REFRIGERANT PIPE SIZE:

LIQUID AND SUCTION REFRIGERANT LINES SHALL BE SIZED PER MANUFACTURER'S RECOMMENDATIONS. HOWEVER, LIQUID LINE VELOCITY SHALL NOT EXCEED 360 FPM, AND THE PRESSURE DROP SHALL BE LIMITED TO A MAXIMUM EQUIVALENT OF 2 DEGREES F OF TEMPERATURE CHANGE. THE SUCTION LINE VELOCITY SHALL BE A MINIMUM OF 500 FPM IN HORIZONTAL LINES, AND A MINIMUM OF 1000 FPM IN VERTICAL RISERS (IF PART LOAD CONDITIONS EXIST, A DOUBLE RISER MAY BE REQUIRED); THE PRESSURE DROP SHALL BE LIMITED TO A MAXIMUM EQUIVALENT OF 2 DEGREES F OF TEMPERATURE CHANGE.

DIFFUSERS, REGISTERS, AND GRILLES SHALL BE BUILDING STANDARD. CEILING DIFFUSERS SHALL BE 4-WAY THROW, UNLESS SHOWN OTHER-WISE ON DRAWINGS.

ALL REGISTERS SHALL BE FURNISHED WITH OPPOSED BLADE DAMPERS. EXACT LOCATION OF ALL CEILING MOUNTED DIFFUSERS, GRILLES, AND REGISTERS TO BE COORDINATED WITH LIGHTING LAYOUT AND REFLECTED CEILING

AUTOMATIC CONTROLS MECHANICAL CONTRACTOR SHALL PROVIDE CONTROLS THAT MATCH THE MANUFACTURER'S RECOMMENDATION FOR ALL EQUIPMENT PROVIDED. CONTROL WIRING SHALL BE #12 CU THHN INSTALLED IN EMT CONDUIT (MINIMUM

1/2" DIAMETER OR PLENUM RATED CABLE. ALL AUTOMATIC CONTROL VALVES AND DAMPERS SHALL BE FURNISHED AND INSTALLED BY THE MECHANICAL CONTRACTOR.

PROVIDE OCCUPANCY SENSORS AS REQUIRED BASED ON SEQUENCE OF OPERATIONS IF NOT PROVIDED FOR LIGHTING CONTROLS OTHERWISE BE ELECTRICAL

EXHAUST FANS: EXHAUST FANS SHALL BE CONTROLLED AS SHOWN ON FAN SCHEDULE.

THERMOSTATS: ALL THERMOSTATS WITH ADJUSTABLE TEMPERATURE SET POINTS SHALL BE MOUNTED WHERE INDICATED ON PLANS 48" AFF, UNLESS NOTED OTHERWISE. AND BE FULLY COORDINATED WITH ARCHITECTURAL PLANS, OWNER GRAPHICS, WALL PATTERNS, LIGHTING CONTROLS/SWITCHES, POWER/DATA OUTLETS, AND ALL OTHER FIELD CONDITIONS. THERMOSTATS SHALL BE BY UNIT MANUFACTURER WITH PRIOR WRITTEN OWNER APPROVAL OF STYLE/TYPE AND COORDINATED PLACEMENT IN FIELD.

THE SEQUENCE OF OPERATIONS PROVIDED IN THE CONTRACT DOCUMENTS IS INTENDED TO COMMUNICATE THE GENERAL DESIGN INTENT TO THE CONTROLS SUBCONTRACTOR AND IS NOT INTENDED TO BE FULLY DEVELOPED OR COMPLETE. IN THE CONTROLS SUBMITTAL, THE SUBCONTRACTOR SHALL FULLY DEVELOP THE SEQUENCE OF OPERATIONS FOR ALL SYSTEMS IDENTIFIED AND SHALL PRESENT ALL SETPOINTS, CONTROL PARAMETERS, AND ALARM POINTS. THE CONTROLS SUBCONTRACTOR SHALL INCORPORATE STANDARD FEATURES SUCH AS MINIMUM RUN TIME DELAYS AND DEAD BANDS FROM SETPOINTS TO PREVENT EQUIPMENT FROM SHORT CYCLING AND WHEN HOVERING AROUND SETPOINTS. ALL MONITORED POINTS SHALL INCLUDE EARLY HIGH/LOW ALARM NOTIFICATIONS PRIOR TO HAVING TO TAKE CORRECTIVE ACTIONS OR EQUIPMENT SHUTDOWNS. TRANSMITTERS SHALL INCLUDE OUT-OF-RANGE, FAIL-SAFE POSITIONING FOR OPEN CIRCUITS OR LOSS OF COMMUNICATION. CONTROL CONTRACTOR SHALL SPECIFY TO FAIL DE-ENERGIZER, HOLD LAST STATE, OR DEFAULT TO A PREDETERMINED SETPOINT. THESE BASIC FEATURES THAT ARE NECESSARY AND ARE PART OF A ROBUST CONTROLS INSTALLATION SHALL BE ASSUMED INCLUDED IN THE SCOPE OF SERVICES FOR DELIVERABLES AT NO ADDITIONAL COSTS TO THE OWNER.

## ARCHITECTURE, PA

1208 CURTIS STREET MONROE, NORTH CAROLINA 28112, TELE: 704-283-2908 FAX: 704-291-7909 cha.architects@frontier.com

CONSULTANTS



P-1817 1001 LANCASTER AVE.



RESTAURANT AY CARAMBA

650 WEST ROOSEVELT BLVD. MONROE, NC 28110

MECHANICAL DRAWING SCHEDULE

	DRAWING NUMBER	DESCRIPTION
	MO.1	MECHANICAL SPECIFICATIONS
	M0.2	MECHANICAL SCHEDULES
	мо.3	MECHANICAL LEGENDS & DETAILS
	M1.1	FLOOR PLAN - MECHANICAL
	M2.1	ROOF PLAN - MECHANICAL
	мз.1	KITCHEN HOOD DRAWINGS
	M3.2	KITCHEN HOOD DRAWINGS
	мз.з	KITCHEN HOOD DRAWINGS
	М3.4	KITCHEN HOOD DRAWINGS
	м3.5	KITCHEN HOOD DRAWINGS
	м3.6	KITCHEN HOOD DRAWINGS
Ī	м3.7	KITCHEN HOOD DRAWINGS
ı		

MECHANICAL CONTRACTOR NOTE:

THE MECHANICAL CONTRACTOR SHALL BE RESPONSIBLE FOR PROVIDING AND INSTALLING THE KITCHEN HOOD SYSTEM AS PRESENTED ON DRAWINGS M.1 THRU M3.7. HE SHALL BE COORDINATE WITH OTHER TRADES AS NEEDED FOR POWER, STRUCTURAL SUPPORT, ETC. ANY SUBSTITUTIONS SHALL BE PRESENTED TO THE ARCHITECT/ENGINEER AS A SHOP DRAWING, SUBMITTED FOR REVIEW AND APPROVAL.

MARK | DATE | DESCRIPTION ISSUE: 08/29/2022 PROJECT NO: 22159 CAD DWG FILE: SEE DRAWINGS DRAWN BY: MMS CHECKED BY: MMS SHEET TITLE

MECHANICAL **SPECIFICATIONS** 

				ROC	OFTO	P UNIT	SCHE	DULE (	DX	CC	OLI	NG /	/W (	GAS	HEA	T)			
ADEA CEDVED	ADEA SERVED SA GA ESE	1 1	COOLING CAPACITY		HEATING CAPACITY (GAS)		IFM	M COMPRESSOR (EA)		ELECTRICAL DATA		OPERATING	MANUEACTURER	NOMINAL	ADDITIONAL				
	CFM		1 .	тс (мвн)	SC (MBH)	EFFICIENCY	INPUT (MBH)	оитрит (мвн)	HP	NO.	RLA	LRA	MCA	моср	VOLTAGE	WEIGHT		1 1	OPTIONS
KITCHEN	3750	825	1.2	116.26	92.50	EER 11.2	150.0	120.0	2.75	2	19.6/13.1		49.0	60	208V-3ø	1300 LBS	YSC120H3ELA	10.0	S
KITCHEN	3600	825	1.2	116.26	92.50	EER 11.2	150.0	120.0	2.75	2	19.6/13.1		49.0	60	208V-3ø	1300 LBS	YSC120H3ELA	10.0	S
SEATING AREA	3200	500	1.2	92.5	71.16	EER 11.2	120.0	97.2	1.0	1	25.0		48.0	60	208V-3ø	1100 LBS	YSC090H3ELA	7.5	S,V
SEATING AREA	4000	500	1.2	116.26	92.50	EER 11.2	150.0	120.0	2.75	2	19.6/13.1		49.0	60	208V-3ø	1300 LBS	YSC120H3ELA	10.0	S,V
	KITCHEN SEATING AREA	KITCHEN 3750 KITCHEN 3600 SEATING AREA 3200	KITCHEN         3750         825           KITCHEN         3600         825           SEATING AREA         3200         500	CFM         CFM         (IN.WC)           KITCHEN         3750         825         1.2           KITCHEN         3600         825         1.2           SEATING AREA         3200         500         1.2	AREA SERVED S.A. CFM O.A. CFM (IN.WC) TC (MBH)  KITCHEN 3750 825 1.2 116.26  KITCHEN 3600 825 1.2 116.26  SEATING AREA 3200 500 1.2 92.5	AREA SERVED S.A. CFM O.A. CFM (IN.WC) TC (MBH) SC (MBH)  KITCHEN 3750 825 1.2 116.26 92.50  KITCHEN 3600 825 1.2 116.26 92.50  SEATING AREA 3200 500 1.2 92.5 71.16	AREA SERVED S.A. CFM O.A. CFM (IN.WC) TC (MBH) SC (MBH) EFFICIENCY  KITCHEN 3750 825 1.2 116.26 92.50 EER 11.2  KITCHEN 3600 825 1.2 116.26 92.50 EER 11.2  SEATING AREA 3200 500 1.2 92.5 71.16 EER 11.2	AREA SERVED S.A. CFM O.A. CFM (IN.WC) TC (MBH) SC (MBH) EFFICIENCY INPUT (MBH)  KITCHEN 3750 825 1.2 116.26 92.50 EER 11.2 150.0  KITCHEN 3600 825 1.2 116.26 92.50 EER 11.2 150.0  SEATING AREA 3200 500 1.2 92.5 71.16 EER 11.2 120.0	AREA SERVED S.A. CFM CFM (IN.WC) CFM (IN.WC) TC (MBH) SC (MBH) EFFICIENCY INPUT (MBH) OUTPUT (MBH)  KITCHEN 3750 825 1.2 116.26 92.50 EER 11.2 150.0 120.0  KITCHEN 3600 825 1.2 116.26 92.50 EER 11.2 150.0 120.0  SEATING AREA 3200 500 1.2 92.5 71.16 EER 11.2 120.0 97.2	AREA SERVED S.A. CFM CFM (IN.WC) CFM (IN.WC) TC (MBH) SC (MBH) EFFICIENCY INPUT (MBH) OUTPUT (MBH) HP  KITCHEN 3750 825 1.2 116.26 92.50 EER 11.2 150.0 120.0 2.75  KITCHEN 3600 825 1.2 116.26 92.50 EER 11.2 150.0 120.0 2.75  SEATING AREA 3200 500 1.2 92.5 71.16 EER 11.2 120.0 97.2 1.0	AREA SERVED S.A. CFM CFM (IN.WC) TC (MBH) SC (MBH) EFFICIENCY INPUT (MBH) OUTPUT (MBH) HP NO.  KITCHEN 3750 825 1.2 116.26 92.50 EER 11.2 150.0 120.0 2.75 2  KITCHEN 3600 825 1.2 116.26 92.50 EER 11.2 150.0 120.0 2.75 2  SEATING AREA 3200 500 1.2 92.5 71.16 EER 11.2 120.0 97.2 1.0 1	AREA SERVED S.A. CFM CFM (IN.WC) TC (MBH) SC (MBH) EFFICIENCY INPUT (MBH) OUTPUT (MBH) HP NO. RLA  KITCHEN 3750 825 1.2 116.26 92.50 EER 11.2 150.0 120.0 2.75 2 19.6/13.1  KITCHEN 3600 825 1.2 116.26 92.50 EER 11.2 150.0 120.0 2.75 2 19.6/13.1  SEATING AREA 3200 500 1.2 92.5 71.16 EER 11.2 120.0 97.2 1.0 1 25.0	AREA SERVED S.A. CFM CFM (IN.WC) TC (MBH) SC (MBH) EFFICIENCY INPUT (MBH) OUTPUT (MBH) HP NO. RLA LRA  KITCHEN 3750 825 1.2 116.26 92.50 EER 11.2 150.0 120.0 2.75 2 19.6/13.1  KITCHEN 3600 825 1.2 116.26 92.50 EER 11.2 150.0 120.0 2.75 2 19.6/13.1  SEATING AREA 3200 500 1.2 92.5 71.16 EER 11.2 120.0 97.2 1.0 1 25.0	AREA SERVED S.A. CFM CFM (IN.WC) TC (MBH) SC (MBH) EFFICIENCY INPUT (MBH) OUTPUT (MBH) HP NO. RLA LRA MCA  KITCHEN 3750 825 1.2 116.26 92.50 EER 11.2 150.0 120.0 2.75 2 19.6/13.1 49.0  KITCHEN 3600 825 1.2 116.26 92.50 EER 11.2 150.0 120.0 2.75 2 19.6/13.1 49.0  SEATING AREA 3200 500 1.2 92.5 71.16 EER 11.2 120.0 97.2 1.0 1 25.0 48.0	AREA SERVED S.A. CFM CFM (IN.WC) TC (MBH) SC (MBH) EFFICIENCY INPUT (MBH) OUTPUT (MBH) HP NO. RLA LRA MCA MOCP  KITCHEN 3750 825 1.2 116.26 92.50 EER 11.2 150.0 120.0 2.75 2 19.6/13.1 49.0 60  KITCHEN 3600 825 1.2 116.26 92.50 EER 11.2 150.0 120.0 2.75 2 19.6/13.1 49.0 60  SEATING AREA 3200 500 1.2 92.5 71.16 EER 11.2 120.0 97.2 1.0 1 25.0 48.0 60	AREA SERVED S.A. CFM CFM (IN.WC) TC (MBH) SC (MBH) EFFICIENCY INPUT (MBH) OUTPUT (MBH) HP NO. RLA LRA MCA MOCP VOLTAGE  KITCHEN 3750 825 1.2 116.26 92.50 EER 11.2 150.0 120.0 2.75 2 19.6/13.1 49.0 60 208V-3ø  KITCHEN 3600 825 1.2 116.26 92.50 EER 11.2 150.0 120.0 2.75 2 19.6/13.1 49.0 60 208V-3ø  SEATING AREA 3200 500 1.2 92.5 71.16 EER 11.2 120.0 97.2 1.0 1 25.0 48.0 60 208V-3ø	AREA SERVED S.A. CFM CFM CFM (IN.WC) TC (MBH) SC (MBH) EFFICIENCY INPUT (MBH) OUTPUT (MBH) HP NO. RLA LRA MCA MOCP VOLTAGE WEIGHT  KITCHEN 3750 825 1.2 116.26 92.50 EER 11.2 150.0 120.0 2.75 2 19.6/13.1 49.0 60 208V-3ø 1300 LBS  KITCHEN 3600 825 1.2 116.26 92.50 EER 11.2 150.0 120.0 2.75 2 19.6/13.1 49.0 60 208V-3ø 1300 LBS  SEATING AREA 3200 500 1.2 92.5 71.16 EER 11.2 120.0 97.2 1.0 1 25.0 48.0 60 208V-3ø 1100 LBS	AREA SERVED S.A. CFM	AREA SERVED S.A. CFM CFM (IN.WC) CFM (IN.WC) TC (MBH) SC (MBH) EFFICIENCY INPUT (MBH) OUTPUT (MBH) HP NO. RLA LRA MCA MOCP VOLTAGE WEIGHT TRANE & MODEL TONS  KITCHEN 3750 825 1.2 116.26 92.50 EER 11.2 150.0 120.0 2.75 2 19.6/13.1 49.0 60 208V-3ø 1300 LBS YSC120H3ELA 10.0  KITCHEN 3600 825 1.2 116.26 92.50 EER 11.2 150.0 120.0 2.75 2 19.6/13.1 49.0 60 208V-3ø 1300 LBS YSC120H3ELA 10.0  SEATING AREA 3200 500 1.2 92.5 71.16 EER 11.2 120.0 97.2 1.0 1 25.0 48.0 60 208V-3ø 1100 LBS YSC090H3ELA 7.5

OPTIONS (ALL UNITS)

BIRD/INSECT SCREENS

PHASE MONITOR

• 14" HIGH PREFAB. ROOF CURB • ≤ 4 TONS; 0-50% LOW AMBIENT CONTROL STANDARD EFFICIENCY MOTORIZED O.A. DAMPER

• ≥ 5 TON; 100% COMPARATIVE • DUAL SLOPED DRAIN SINGLE POINT ELEC. CONN. ENTHALPY ECONOMIZER /W DX COOLING, GAS HEAT FACTORY TRAINED BAROMETRIC RELIEF 2000+ CFM: DUCT SMOKE START-UP DETECTOR, SEE NOTE #3 CONDENSATE DRAIN PAN 5-YEAR FACTORY OVERFLOW SWITCH STANDARD CONDENSER COIL

ADDITIONAL OPTIONS (UNITS AS NOTED) A: BACNET/LONTALK CONTROLS

B: DEMAND CONTROL VENTILATION C: CO2 SENSOR, WALL MOUNTED D: CO2 SENSOR, DUCT MOUNTED E: HUMIDITY SENSOR, WALL MOUNTED F: HUMIDITY SENSOR, DUCT MOUNTED

G: HINGED ACCESS PANELS

H: VIBRATION ISOLATION ROOF CURB P: DISCHARGE AIR TEMP KIT J: INSULATED CURB VOID FOR SOUND Q: FROSTAT K: CORROSION RESISTANT CONDENSER COIL R: HIGH STATIC DRIVE L: HOT GAS REHEAT

S: HAIL GUARDS T: LAT SENSOR, DUCT MOUNTED U: EAT SENSOR, DUCT MOUNTED

COMPRESSOR WARRANTY 7-DAY PROGRAMMABLE DIGITAL 1ST YEAR PARTS & THERMOSTAT LABOR

M: STAINLESS STEEL HEAT EXCHANGER N: STAINLESS STEEL DRAIN PAN V: BI-POLAR IONIZATION FILTER DEVICE O: CLOGGED FILTER SWITCH

NOTES:

1. ALL UNITS SHALL BE AGA CERTIFIED AND U.L. LABELED.

2. ALL UNITS SHALL BE SUPPLIED BY ONE MANUFACTURER UNLESS NOTED OTHERWISE.

• 2" FILTERS

3. ELECTRICAL CONTRACTOR SHALL PROVIDE EACH UNIT WITH A SMOKE DETECTOR. THE SMOKE DETECTOR SHALL BE IONIZATION TYPE WIRED TO SHUT-DOWN UNIT WHEN ACTIVATED. THE SMOKE DETECTOR SHALL BE INSTALLED IN THE RETURN DUCT BY THE MECHANICAL CONTRACTOR

THE SMOKE DETECTOR SHALL BE WIRED BY THE ELECTRICAL CONTRACTOR TO AN AN HVAC MONITORING PANEL. THE PANEL SHALL PROVIDE VISUAL AND AUDIBLE SIGNAL. THE SIGNAL SHALL INDICATE AND BE LABELED AS AIR DETECTOR TROUBLE. THE PANEL SHALL BE SUPPLIED AND INSTALLED BY ELECTRICAL CONTRACTOR.

PROVIDE SMOKE DETECTOR WITH REMOTE ALARM OR SUPERVISORY INDICATING DEVICES. EACH REMOTE DEVICE SHALL BE PERMANENTLY LABELED TO ACCURATELY IDENTIFY THE UNIT SERVED.

EAN SCHEDULE

								DULL					
TAG	AREA SERVED	FAN TYPE	СҒМ	ESD	DRIVE TYPE	RPM	ELECTRICAL DATA			SONES	OPERATING	MANUFACTURER	ODTIONS
IAG	AREA SERVED	FAN TIPE	Сгм	E.S.P. (IN.WC)			H.P.	WATTS	VOLTAGE	SUNES	WEIGHT	& MODEL NO.	OPTIONS
EF-1	RESTROOM	CEILING EXHAUST	150	0.25	DIRECT	1400		52.4	115V-1ø	1.5	17 LBS	SP-A190L	A,B,F,K,S
KEF-1	HOOD (BY MC)	ROOF EXHAUST	2220	1.25	DIRECT	1120	2	-	208V-3ø	13.6	160 LBS	CAPTIVEAIRE DU180HFA	G,U
KEF-2	HOOD (BY MC)	ROOF EXHAUST	2880	1.25	DIRECT	1200	2	-	208V-3ø	17.4	185 LBS	CAPTIVEAIRE DU180HFA	G,U
EF-3	DISHWASHER HOOD	ROOF EXHAUST	600	0.375	DIRECT	1490	1/4	-	120V-1ø	93	60 LBS	GREENHECK G-098VG-1/4	A,B,F,Q
MUA-1	MAKE-UP AIR FAN	HOOD MAKE-UP AIR	4069	0.50	DIRECT	1679	3	_	208V-3ø	17.6	1620LBS	CAPTIVEAIRE A2-D.250-20D-MPU	A,C,G

<u>OPTIONS</u>

A: DISCONNECT SWITCH B: BACKDRAFT DAMPER

D: BIRDSCREEN

C: PREFAB. ROOF CURB

E: SHORT BASE OPTION

F: HANGING BRACKETS

WITH VIBRATION ISOLATION

G: KITCHEN EXHAUST FAN PROVIDED WITH

HOOD PACKAGE. REFER TO HOOD DRAWINGS FOR DETAILS. H: PROVIDE CORROSION PROTECTION FOR

EXTERIOR EXHAUST FANS LOCATED WITHIN

1 MILE OF OCEAN OR SALT WATER BODY. L: WL, WALL LOUVER DISCHARGE M: RFC, ROOF CAP (FLAT ROOF) RL. ROOF CAP ( PITCHED ROOF)

I: WALL MOUNTED THERMOSTAT J: PROVIDE FACTORY FAN SPEED CONTROLLER TO BALANCE FAN

K: INTERLOCKED WITH LIGHTING FIXTURE SWITCH

WITH MANUAL DAMPER

N: MOTORIZED DAMPER - 120V

R: EXHAUST METAL GRILLE SENSOR (PROVIDED BY E.C. - SEE ELEC. DWGS FOR LOCATION)

O: PROVIDE FAN WITH FREE STANDING T: RUN CONTINUOUSLY DURING OCCUPIED HOUR SPRING ISOLATORS AND VIBRATION USE, CONNECTED VIA LIGHTING CONTROL. ISOLATION RAILS, W/ WIND (CONTROL PROVIDED BY E.C. - SEE ELEC.

RESTRAINTS DWGS FOR LOCATION) P: WASHABLE ALUMINUM FILTERS U: INTERLOCK W/ RTU(S)/AHU(S) FOR MAKE-UP AIR Q: ON/OFF WITH HOOD MOUNTED SWITCH V: HEATER - 231 MBH IN, 213 MBH OUT (92% EFF) W: FOR OUTDOOR INSTALLATION S: INTERLOCKED WITH LIGHTING OCCUPIED X: 3-WAY DIFFUSER BY MANUFACTURER

Y: RATED FOR HIGH TEMPERATURE OPERATION UP TO 450°F.

1. ALL FANS SHALL BE U.L. LABELED.

2. ALL FANS SHALL BE SUPPLIED BY ONE MANUFACTURER UNLESS NOTED OTHERWISE.

3. BACKDRAFT DAMPER ON ROOF SUPPLY FANS SHALL BE MOTORIZED.

DAMPER SHALL BE CLOSED DURING UNOCCUPIED TIMES.

## SEQUENCE OF OPERATION

RTU-1 THE SA FANS IN THE RTUS SHALL RUN CONTINUOUSLY DURING OCCUPIED HOURS. THE SA FANS SHALL SHALL BE
RTU-2 INTERLOCKED TO RUN WHEN KEF-1, KEF-2 AND MUA-1 ARE ENGERGIZED. KEF-1 AND KEF-2 SHALL BE INTERLOCKED WITH RTU-3 MUA-1 TO RUN SIMULTANEOUSLY.

ALL AREAS - THE FAN SHALL RUN CONTINUOUSLY DURING OCCUPIED HOURS. ON A CALL FOR COOLING, THE 1ST STAGE OF COOLING SHALL ENERGIZE. IF THE THERMOSTAT CALLS FOR ADDITIONAL COOLING, THE SECOND STAGE SHALL ENERGIZE IF THE THERMOSTAT CONTINUES TO RISE AND CALLS FOR MORE COOLING, THE FIRST STAGE OF COOLING SHALL ENERGIZE AND CONTINUE TO RUN UNTIL THE THERMOSTAT IS SATISFIED. AS THE NEED FOR COOLING DECREASES, THE COMPRESSOR SHALL UNLOAD IN A SIMILAR STEP PROCESS.

OFF-HOURS OPERATION - RTU-1, RTU-2, RTU-3 AND RTU-4 SHALL BE FIELD WIRED TO STILL HAVE OPERATION DURING UNOCCUPIED HOURS AND WHEN HOOD SYSTEM IS NOT IN OPERATION. RTUS SHALL BE CAPABLE OF VENTILATING, COOLING AND/OR HEATING AS SYSTEM THERMOSTAT DEMANDS WHETHER HOOD SYSTEM IS IN OPERATION OR NOT TO MAINTAIN MINIMUM SET BACK TEMPS DURING UNOCCUPIED HOURS.

ON WINTER OPERATION - ON A CALL FOR HEATING, FIRST STAGE OF HEAT SHALL ENERGIZE TO HEAT THE SPACE. AS THE SPACE TEMPERATURE CONTINUES TO FALL, THE SECOND STAGE, IF APPLICABLE, SHALL ENERGIZE AS NEEDED TO MAINTAIN OUTSIDE AIR DAMPERS -- THE NORMALLY CLOSED MOTOR OPERATED OUTSIDE AIR DAMPER SHALL OPEN WHEN THE

FAN IN THE ROOF TOP UNITS ARE ENERGIZED EITHER DURING OCCUPIED HOURS OR WHEN KEF-1, KEF-2 ARE ENERGIZED. THE

OBD MANUFACTURER ADDITIONAL SERVICE CFM RANGE FACE SIZE | NECK SIZE TYPE TAG PRICE & MODEL OPTIONS 50 - 125 SQUARE PLAQUE NO SPD SUPPLY 24×24 6"ø SQUARE PLAQUE NO SPD (B) SUPPLY 180 - 270 24x24 10**"**ø SUPPLY 275 - 425 24x24 12"ø SQUARE PLAQUE NO SPD SQUARE PLAQUE SPD SUPPLY 430 - 950 24x24 14**"**ø (E) SUPPLY 600 - 85024x24 CAPTIVEAIRE DI-PSP (LAMINAR FLOW) 14"ø SPIRAL DUCT GRILLE NO SDG-ST SUPPLY 200 -260 24x24 14"ø SUPPLY 335 - 400 24x24 SPIRAL DUCT GRILLE NO SDG-ST G 14"ø PDDR RETURN 600 - 1500 24×24 18"x18" PERFORATED FACE NO (A) EXHAUST 665 24x24 14"ø PERFORATED FACE NO PDDR

GRILLES, REGISTERS, AND DIFFUSERS SCHEDULE

ADDITIONAL OPTIONS (AS NOTED)

A: ADJUST FROM HORIZONTAL DISCHARGE TO VERTICAL DISCHARGE. PROVIDE DIFFUSER WITH SQUARE TO ROUND NECK ADAPTOR, MODEL #SR B: PROVIDE REGISTER WITH ROUND NECK ADAPTOR WHERE REQUIRED.

ALL DEVICES SHALL BE FINISHED WITH AN ENAMEL FINISH, COLOR BY ARCHITECT. COORDINATE DEVICE COLOR(S) WITH ARCHITECT PRIOR TO ORDERING. COLOR COORDINATION SHALL INCLUDE BUT NOT BE LIMITED TO DIFFUSER FACE, CENTER TEE, FRAME INTERIOR, PATTERN CONTROLLER, ETC.

2. ALL DEVICES SHALL BE FURNISHED WITH FRAMES SUITABLE FOR TYPE OF INSTALLATION REQUIRED, NO EXCEPTIONS. PROVIDE EXTERNAL BACK INSULATION, FACTORY INSTALLED FOR ALL DIFFUSER/GRILLE HOUSING.

4. PROVIDE TAPERED TRANSITIONS FOR ALL SUPPLY DIFFUSERS WITH NECK SIZES DIFFERENT THAN SUPPLY DUCT RUN-OUT SIZES.

5. ALL DEVICES INSTALLED IN HARD CEILINGS, WALLS, OR DIRECTLY ATTACHED TO DUCTS SHALL BE PROVIDED WITH OBD'S. 6. COORDINATE GRILLES/DIFFUSERS WITH ARCHITECTURAL CEILING AND STRUCTURAL FRAMING LAYOUTS PRIOR TO ORDERING. COORDINATION SHALL INCLUDE TYPE OF INSTALLATION, MOUNTING REQUIREMENTS, T-BAR SPACING/SIZE, GYPBOARD

FRAMING, INSTALLATION CLEARANCES, ETC. . CONTRACTOR SHALL PAINT ALL VISIBLE SURFACES THROUGH GRD'S FLAT BLACK. PLENUM BOX INSULATION SHALL BE COLOR BLACK FROM FACTORY.

8. PROVIDE SPIN-IN TAP WITH MANUAL VOLUME DAMPER AT EACH BRANCH TAKE-OFF. SEE DETAILS SHEET AND

SPECIFICATIONS FOR ADDITIONAL INFORMATION. 9. SEE AIR DEVICE TAG FOR DUCT INLET SIZE. ALL DUCT RUNOUTS TO BE SIZED PER GRD AIR TERMINAL NECK SIZE ON SCHEDULE AND/OR AS INDICATED ON PLANS IN CONJUNCTION WITH REQUIREMENTS BY GRD MANUFACTURER. COORDINATE ALL DUCT SIZES PRIOR TO BIDDING, NO EXCEPTIONS. DUCT SIZE SHALL MATCH GREILLE/LOUVER SIZE IF NO DUCTWORK SIZE INDICATED ON

PLANS. CONTRACTOR SHALL REFERENCE DUCTWORK INSULATION SCHEDULE FOR ALL DUCTWORK INSULATION REQUIREMENTS. 10. TEE-BAR CEILING GRID IS USED. GENERAL CONTRACTOR SHALL MAKE SURE THE GRILLES/DIFFUSERS/LIGHITING FIXTURES

WILL FIT PROPERLY IN THE NARROW GRID. 

UNIT = WATER CLOSET OR URINAL

TAG	TYPE	SUPPLY AIR (CFM)	RETURN AIR (CFM)	OUTSIDE AIR (CFM)	EXHAUST (CFM)
RTU-1	NEW RTU	3750	2925	825	N/A
RTU-2	NEW RTU	3600	2775	825	N/A
RTU-3	NEW RTU	3200	2700	500	N/A
RTU-4	NEW RTU	4000	3500	500	N/A
MUA-1	NEW MAKE-UP AIR UNIT	4069	0	4069	N/A
EF-1 (2)	GENERAL EXHAUST	N/A	N/A	N/A	-300
KEF-1	KITCHEN HOOD EXHAUST FAN	N/A	N/A	N/A	-2220
KEF-2	KITCHEN HOOD EXHAUST FAN	N/A	N/A	N/A	-2880
EF-3	DISHWASHER HOOD	N/A	N/A	N/A	-600
	TOTAL	18,619	11,900	6,719	-6,000

NOTE: AIR BALANCE BASED ON ALL HVAC SYSTEMS, AND KITCHEN HOOD RUNNING SIMULTANEOUSLY. EXCESS POSITIVE CFM WILL BE RELIEVED THRU RTU-3 AND RTU-4. TO MAINTAIN A POSITIVE PRESSURE OF 200 CFM (TARGET POINT).

EXHAUST AIR CALCULATION

ROOM NAME	AREA (SQ.FT) NET	NUMBER OF UNIT	CFM/UNIT	NET AREA O.A. RATE (CFM/SQ FT)	REQUIRED EXHAUST (CFM)	PROVIDED EXHAUST (CFM)	SERVED BY
MEN 110	153	2	70	_	140	150	EF-1
WOMEN 111	153	2	70	_	140	150	EF-1
KITCHEN	1128	_	-	0.7	653	5100	KEF-1, KEF-

NORTH CAROLINA **ENERGY CODE** (2018 North Carolina Energy Conservation Code) MECHANICAL SYSTEMS, SERVICE SYSTEMS AND EQUIPMENT METHOD OF COMPLIANCE:

PRESCRIPTIVE X ENERGY COST BUDGET THERMAL ZONE: 3A EXTERIOR DESIGN CONDITIONS winter dry bulb 93° F. summer dry bulb INTERIOR DESIGN CONDITIONS winter dry bulb summer dry bulb relative humidity 50% R.H.

BUILDING HEATING LOAD 121 MBH (PEAK) BUILDING COOLING LOAD 247 MBH (PEAK) MECHANICAL SPACING CONDITIONING SYSTEM

GAS ROOF TOP PACKAGED UNITS description of unit heating efficiency SEE SCHEDULES cooling efficiency SEE SCHEDULES SEE SCHEDULES heat output of unit cooling output of unit SEE SCHEDULES N/A total boiler output of unit

CHILLER total chiller capacity N/A LIST EQUIPMENT EFFICIENCIES Equipment schedules with motors (mechanical systems) motor horsepower number of phases minimum efficiency N/A motor type # of poles

501.2 APPLICATION COMPLIANCE / 506 ADDITIONAL PRESCRIPTIVE COMPLIANCE: ☐ 506.2.1 MORE EFFICIENT MECH. EQUIPMENT ☐ 506.2.4 HIGHER EFF DOMESTIC HW

X 506.2.2 REDUCED LTG DENSITY ☐ 506.2.5 ON—SITE RENEWABLE ENERGY ☐ 506.2.3 ENERGY RECOVERY SYSTEM 506.2.6 DAYLIGHT CONTROLS

DESIGNER STATEMENT: 1 To the best of my knowledge and belief, the design of this building complies with the mechanical systems, service systems and equipment requirements of the 2018 North Carolina Energy Conservation Code.

NAME: M. MICHAEL SCHON, P.E. TITLE: MECHANICAL ENGINEER


ARCHITECTURE, PA

1208 CURTIS STREET MONROE, NORTH CAROLINA 28112, TELE: 704-283-2908 FAX: 704-291-7909 cha.architects@frontier.com

CONSULTANTS



P-1817 1001 LANCASTER AVE. MONROE, NC 28112 704-282-0826

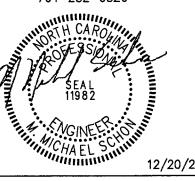

RESTAURANT AY CARAMBA

650 WEST ROOSEVELT BLVD. MONROE, NC 28110

12/20/22 OWNER VE CHANGES MARK | DATE | DESCRIPTION

ISSUE: 08/29/2022 PROJECT NO: 22159

CAD DWG FILE: SEE DRAWINGS **DRAWN BY:** MMS **CHECKED BY: MMS** 

SHEET TITLE

MECHANICAL **SCHEDULES** 

M0.2

iewed for Code Compliance
ty of Monroe Building Standards
vroperty owner is responsible for compliance
all applicable Local, State and Federal Laws.
uthorization does not permit a violation of any
City, State or Federal Laws.

Examiner:
Date: 04/06/2023


NOTES:

1. PROVIDE OPENING IN ROOF SIZED FOR SUPPLY AND RETURN DUCTS. ALL OTHER AREAS UNDER UNIT SHALL HAVE ANGLES AND SHEET METAL ACROSS UNDER UNIT WITH BATT INSULATION FILLING VOID.

2. ROOF CURBS SHALL MATCH SLOPE OF ROOF.

3. SMOKE DETECTORS SHALL BE IONIZITION TYPE WIRED TO SHUT DOWN THE UNIT UPON ACTIVATION. SMOKE DETECTORS SHALL BE PROVIDED AND WIRED BY THE ELECTRICAL CONTRACTOR AND


INSTALLED IN THE DUCT BY THE MECHANICAL CONTRACTOR.

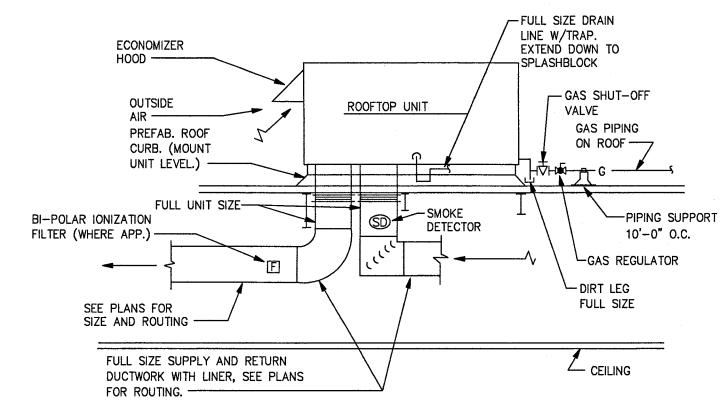

GAS-FIRED

ROOFTOP UNIT DETAIL


SCALE: NONE

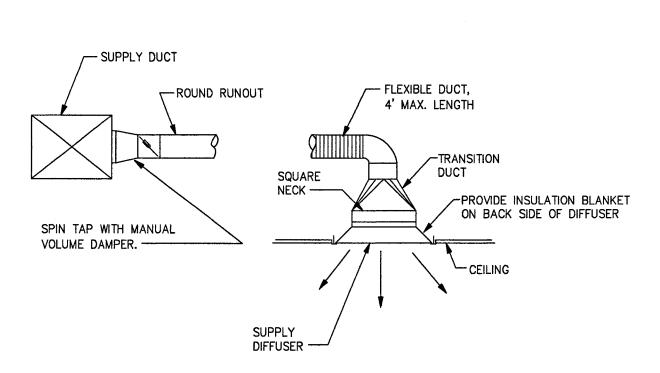

SPIN TAP TO

SQUARE NECK DIFFUSER


SCALE: NONE

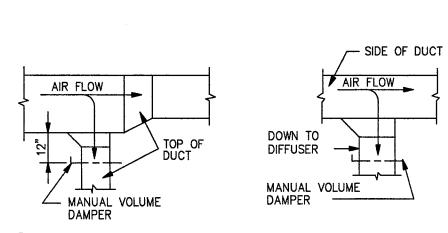

①
BRANCH TAKE-OFF

ARE SAME DEPTHS

SINGLE DROP

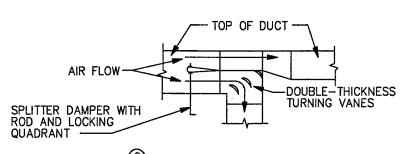


BRANCH TAKE-OFF

NOTE:

1. USE BRANCH TAKE-OFF WHEN MAIN AND BRANCH DUCTS
ARE DIFFERENT DEPTHS

2. USE BRANCH TAKE-OFF WHEN MAIN AND BRANCH DUCTS


7 DUCTWORK DETAIL
SCALE: NONE

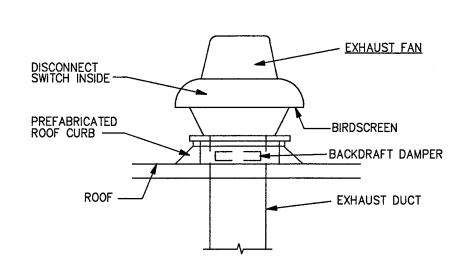


ROOF-MOUNTED

EXHAUST FAN DETAIL

SCALE: NONE

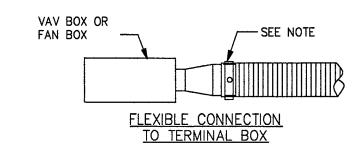



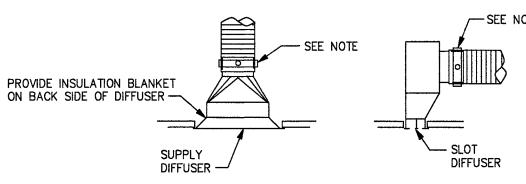


FLEXIBLE CONNECTION TO SUPPLY DIFFUSER

NOTE: ALL FLEXIBLE DUCT CONNECTIONS TO SHEET
METAL SHALL BE SECURED WITH NYLON STRAP AND 2


TYPICAL

FLEX. CONNECTION DETAILS

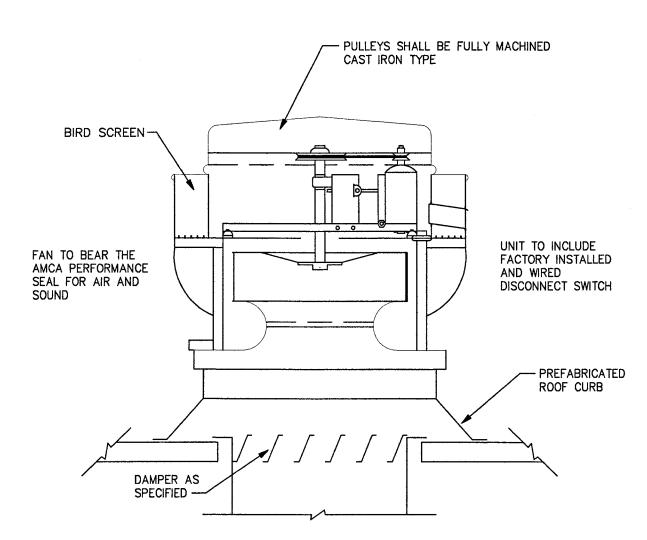



8 CENTRIFUGAL UPBLAST ROOF EXHAUST FAN SCALE: NONE

NOTE:
FANS HANDLING GREASE LADEN AIR SHALL BE PROVIDED WITH GREASE
DRIP TRAYS/GUTTERS AND HINGED FAN ACCESS. GREASE GUTTER SHALL
DRAIN TO A COLLECTION CONTAINER. CONTAINER SHALL BE DRAINED AS
PART OF MAINTENANCE SCHEDULE BASED ON THE COLLECTION RATE AND
SIZE OF THE CONTAINER.

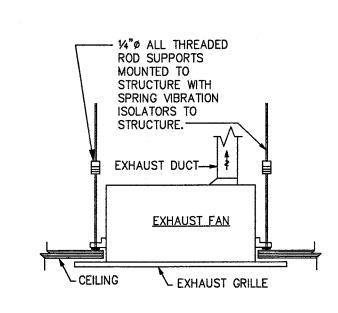



3 CEILING MOUNTED FAN DETAIL
SCALE: NONE

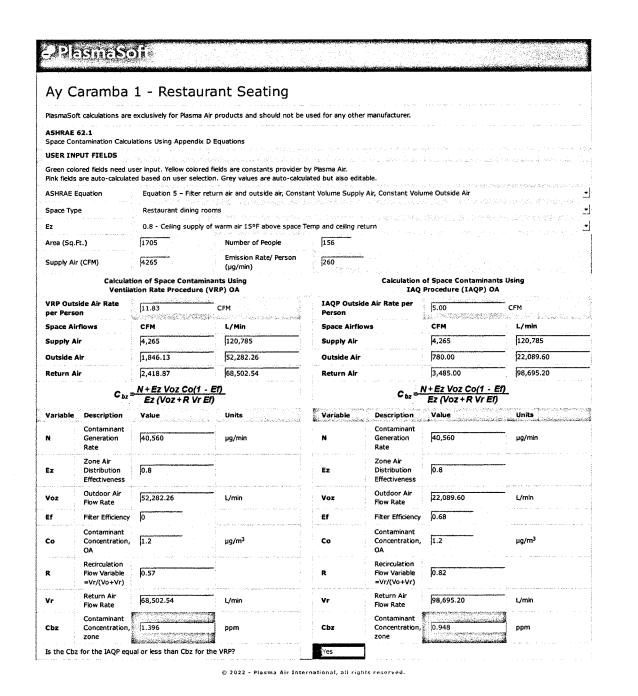

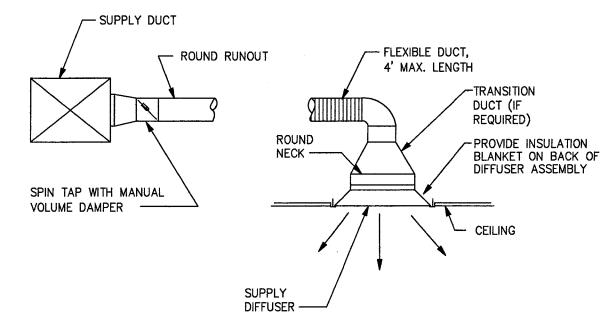

SPIN TAP TO ROUND NECK DIFFUSER

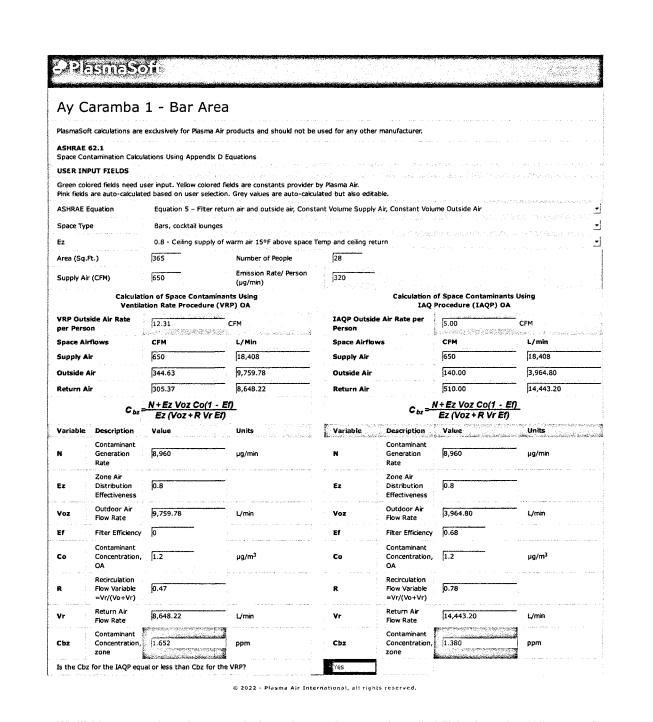

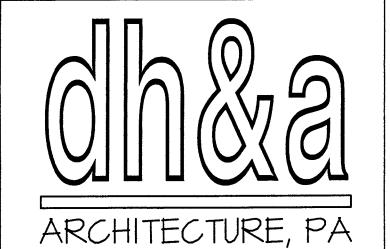

1208 CURTIS STREET MONROE, NORTH CAROLINA 28112, TELE: 704-283-2908 FAX: 704-291-7909 cha.architects@frontier.com

CONSULTANTS



RESTAURANT AY CARAMBA

650 WEST ROOSEVELT BLVD. MONROE, NC 28110

MARK DATE DESCRIPTION

ISSUE: 08/29/2022

PROJECT NO: 22159


CAD DWG FILE: SEE DRAWINGS

DRAWN BY: MMS

CHECKED BY: MMS

MECHANICAL DETAILS

M0.3

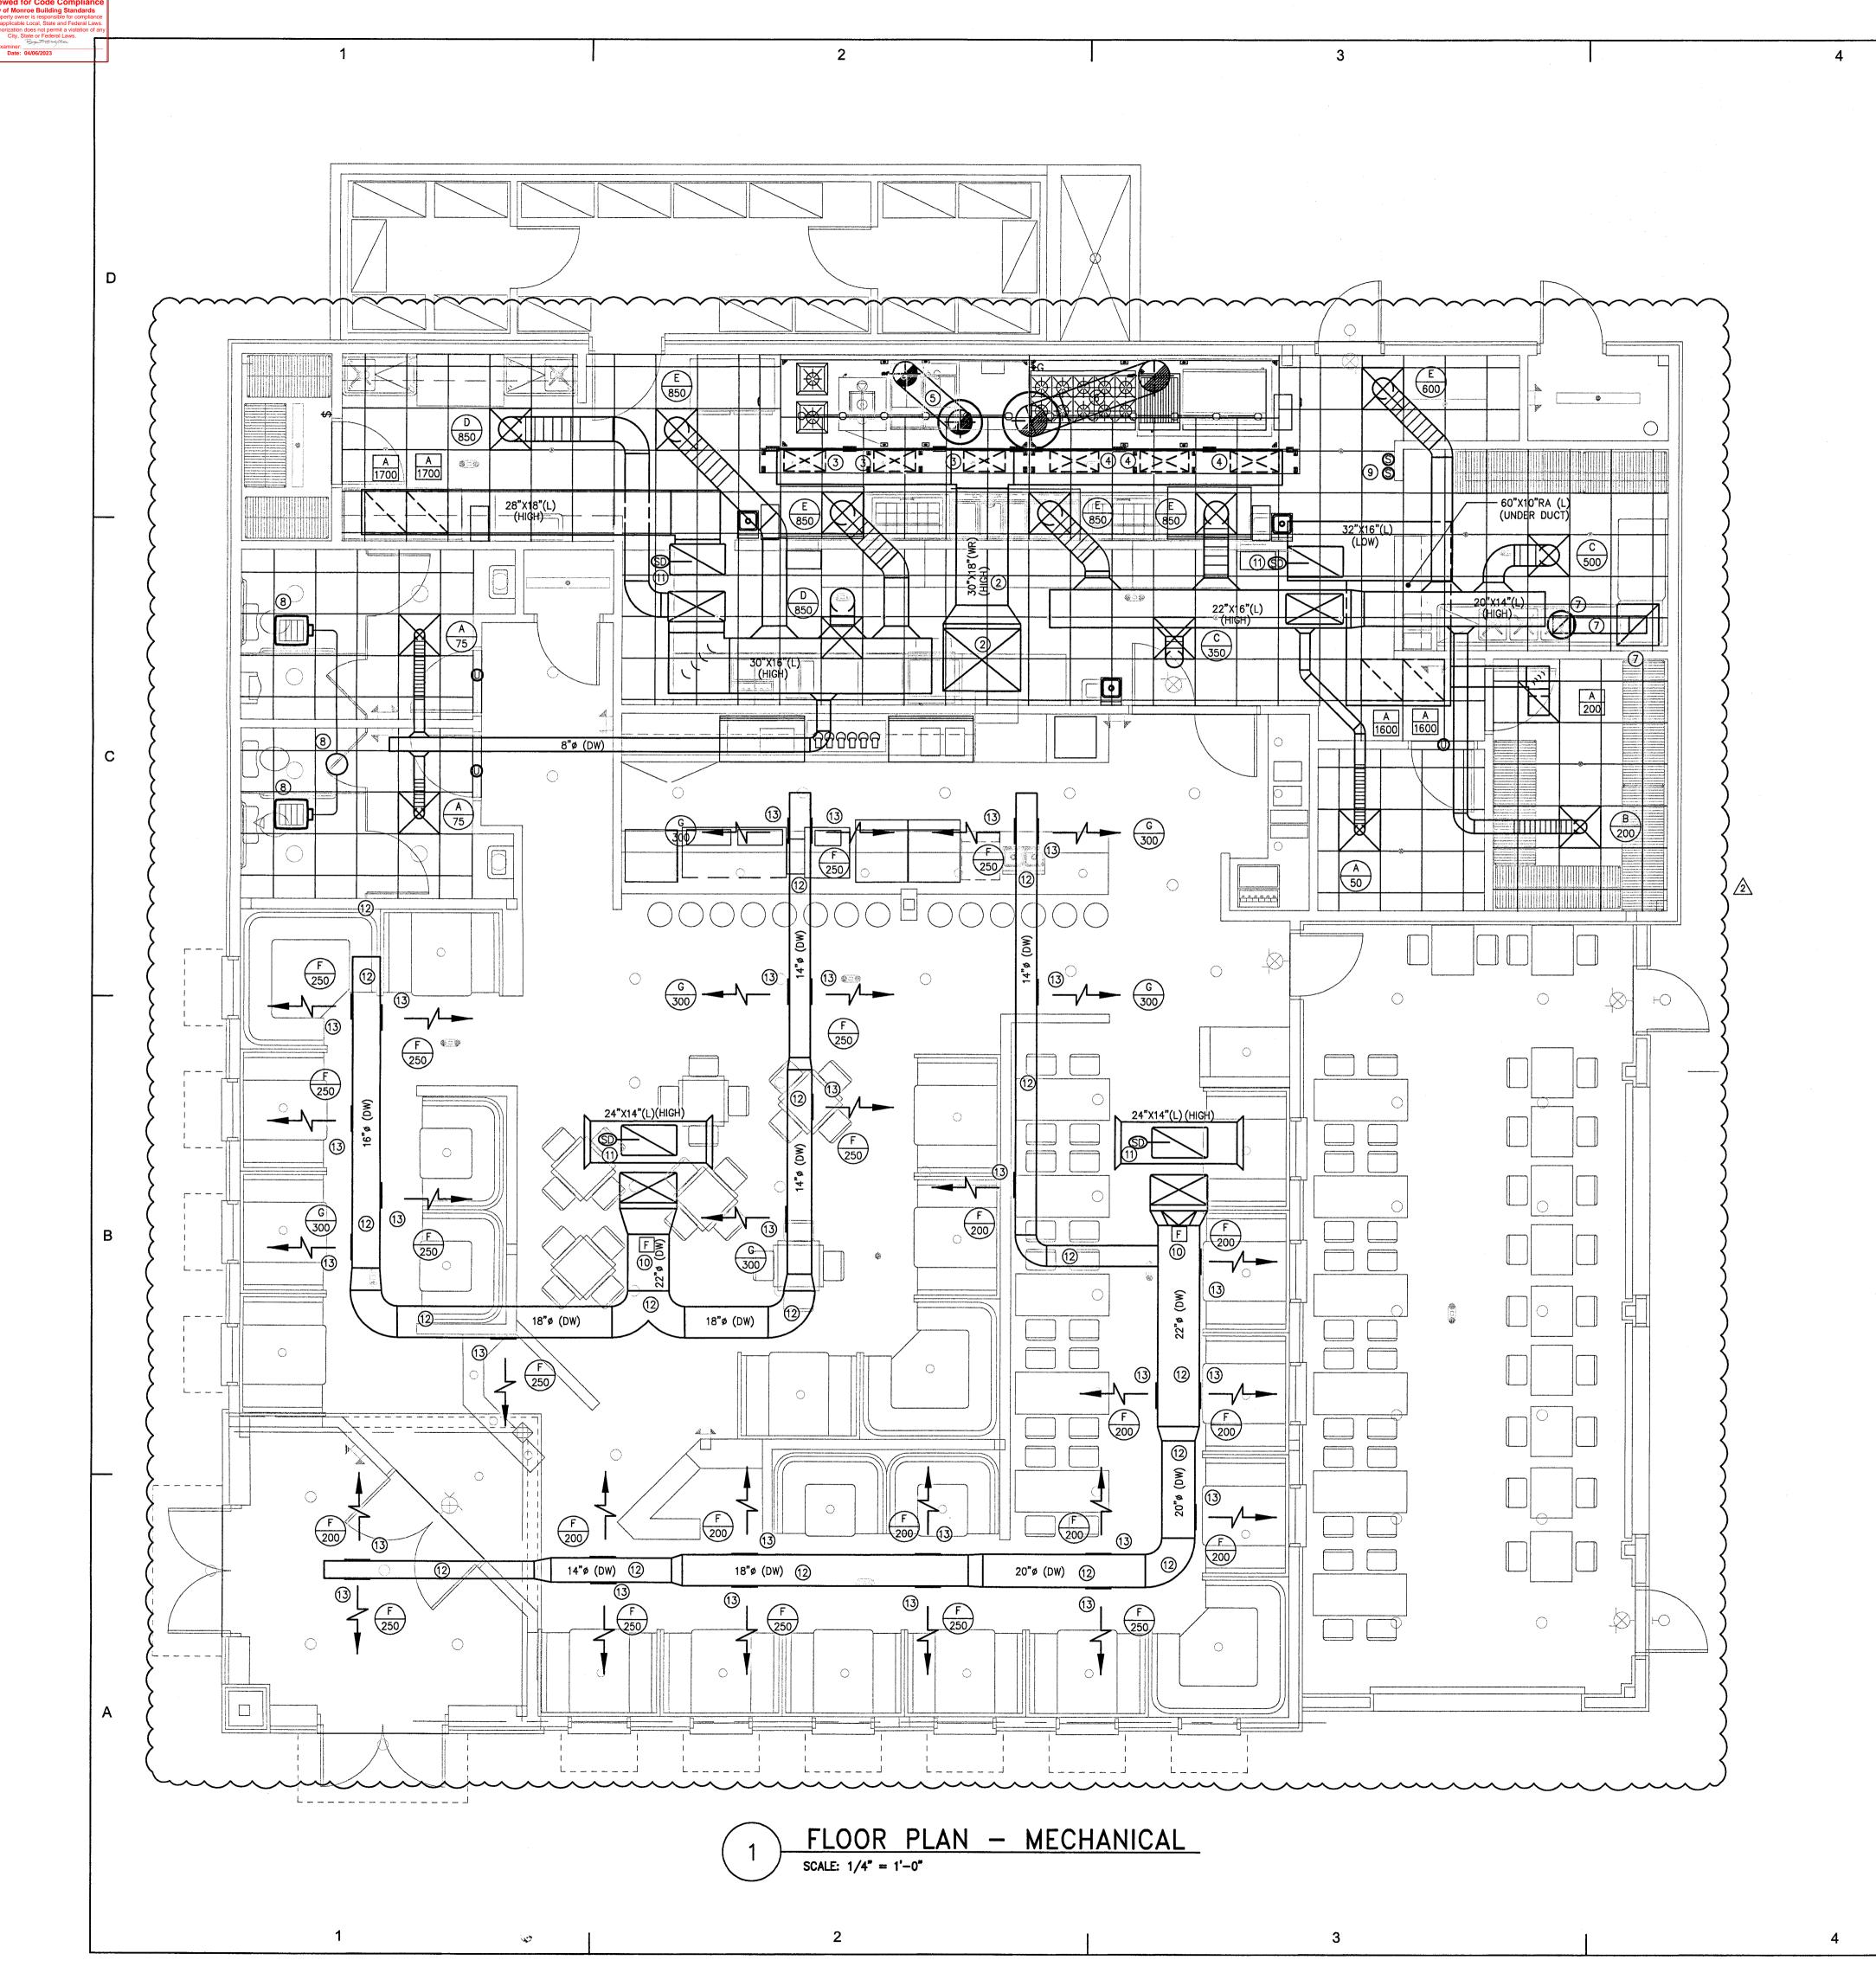

## NOTES THIS SHEET

- 1 SEE SHEETS MO.1 MO.3 FOR SCHEDULES, DETAILS AND SPECIFICATIONS.
- 2 NEW 30"X18" SA FROM MUA-1 UNIT, TRAANISTION TO UNIT CONNECTION SIZE AS REQUIRED. ROUTE NEW DUCT TO 20"X18" MAU DUCT THAT PROVIDES AIR TO THE SA PLENUM AT HOOD.
- 3 24"X12" MUA CONNECTION FROM 20"X18" MUA DUCT TO CONNECTION AT HOOD, TYPICAL OF THREE, BALANCE AIR TO 636 CFM EACH. PROVIDE MANUAL BALANCING DAMPER AT HOOD CONNECTION.
- 4 28"X12" MUA CONNECTION FROM 20"X18" MUA DUCT TO CONNECTION AT HOOD, TYPICAL OF THREE, BALANCE AIR TO 720 CFM EACH. PROVIDE MANUAL BALANCING DAMPER AT HOOD CONNECTION.
- 14" GREASE DUCT (16 GAUGE, CARBON STEEL, WELDED CONTINUOUSLY).
  TIE INTO CONNECTION AT HOOD AND ROUTE AS INDICATED TO KITCHEN HOOD EXHAUST FAN, KEF-1. PROVIDE 2 LAYERS OF FIRE MASTER INSULATION WHERE THE EXHAUST DUCT IS CLOSER THAN 18" TO COMBUSTIBLES. PROVIDE UL LISTED CLEANOUTS AT ALL 90 DEGREE ELBOWS AND EVERY 20 FEET OF LENGTH. FIELD VERIFY EXACT LOCATION/CONDITIONS.
- 18" GREASE DUCT (16 GAUGE, CARBON STEEL, WELDED CONTINUOUSLY).
  TIE INTO CONNECTION AT HOOD AND ROUTE AS INDICATED TO KITCHEN HOOD EXHAUST FAN, KEF-2. PROVIDE 2 LAYERS OF FIRE MASTER INSULATION WHERE THE EXHAUST DUCT IS CLOSER THAN 18" TO COMBUSTIBLES. PROVIDE UL LISTED CLEANOUTS AT ALL 90 DEGREE ELBOWS AND EVERY 20 FEET IN LENGTH. FIELD VERIFY EXACT LOCATION/CONDITIONS.
- 7 10"X10" ALUMINUM DUCT FROM 2'X2'X12" ALUMINUM HOOD AT DISHWASHER. DUCT SHALL SLOPE BACK TOWARDS THE HOOD. DUCT SHALL BE CAULKED FOR WATERPROOF JOINTS. ROUTE TO ROOF MOUNTED EXHAU FAN, EF-3.
- 8 CEILING EXHAUST FAN, <u>EF-1</u>, ROUTE 8"Ø EXHAUST DUCT TO COMMON 10"Ø EXHAUST DUCT THAT EXTENDS UP TO ROOF CAP, FIELD VERIFY EXACT LOCATION. MAINTAIN 10FEET BETWEEN ANY EXHAUST TERMINATION AND OUTSIDE AIR INTAKE.
- EMERGENCY SHUT DOWN BUTTON FOR KITCHEN HOOD, FIELD VERIFY EXACT LOCATION.
- PROVIDE PLASMA FILTER, EQUAL TO PLASMA AIR 7000 SERIES IN SA DUCT MAIN. SEE CALCULATIONS ON SHEET MO.3.
- PROVIDE EACH UNIT WITH A UL LISTED, SMOKE DETECTOR IN RETURN AIR DUCT MAIN TO SHUT UNIT DOWN UPON ACTIVATION. PROVIDE AND INSTALL REMOTE ANNUNCIATING DEVICE WITH A KEYED OVERRIDE, REMOTE ANNUNCIATING DEVICE SHALL BE LOCATED IN A ROUTINELY OCCUPIED AREA AND SHALL IDENTIFY ASSOCIATED EQUIPMENT IN ALARM.
- SPIRAL DUCT SHALL BE DOUBLED WALL (DW). THE DUCT SHALL BE SUPPORTED FRM STRUCTURE WITH ALL THREAD RODS PER MANUFACTURER'S AND SMACNA STANDARDS.
- GRILLES IN THE SPIRAL DUCT SHALL BE MOUNTED AT 30 DEGREES DOWNWARD FROM HORIZONTAL.

1208 CURTIS STREET MONROE, NORTH CAROLINA 28112, TELE: 704-283-2908 FAX: 704-291-7909 cha.architects@frontier.com


ARCHITECTURE, PA

CONSULTANTS



ENGINEERING

P-1817 1001 LANCASTER AVE. MONROE, NC 28112 704-282-0826

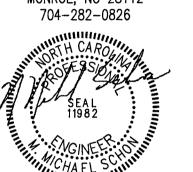

RESTAURANT AY CARAMBA I

650 WEST ROOSEVELT BLVD. MONROE, NC 28110

12/20/22 OWNER VE CHANGES

MARK DATE DESCRIPTION

ISSUE: 08/29/2022

PROJECT NO: 22159


CAD DWG FILE: SEE DRAWINGS

SHEET TITLE


DRAWN BY: MMS
CHECKED BY: MMS

FLOOR PLAN MECHANICAL

M1.1

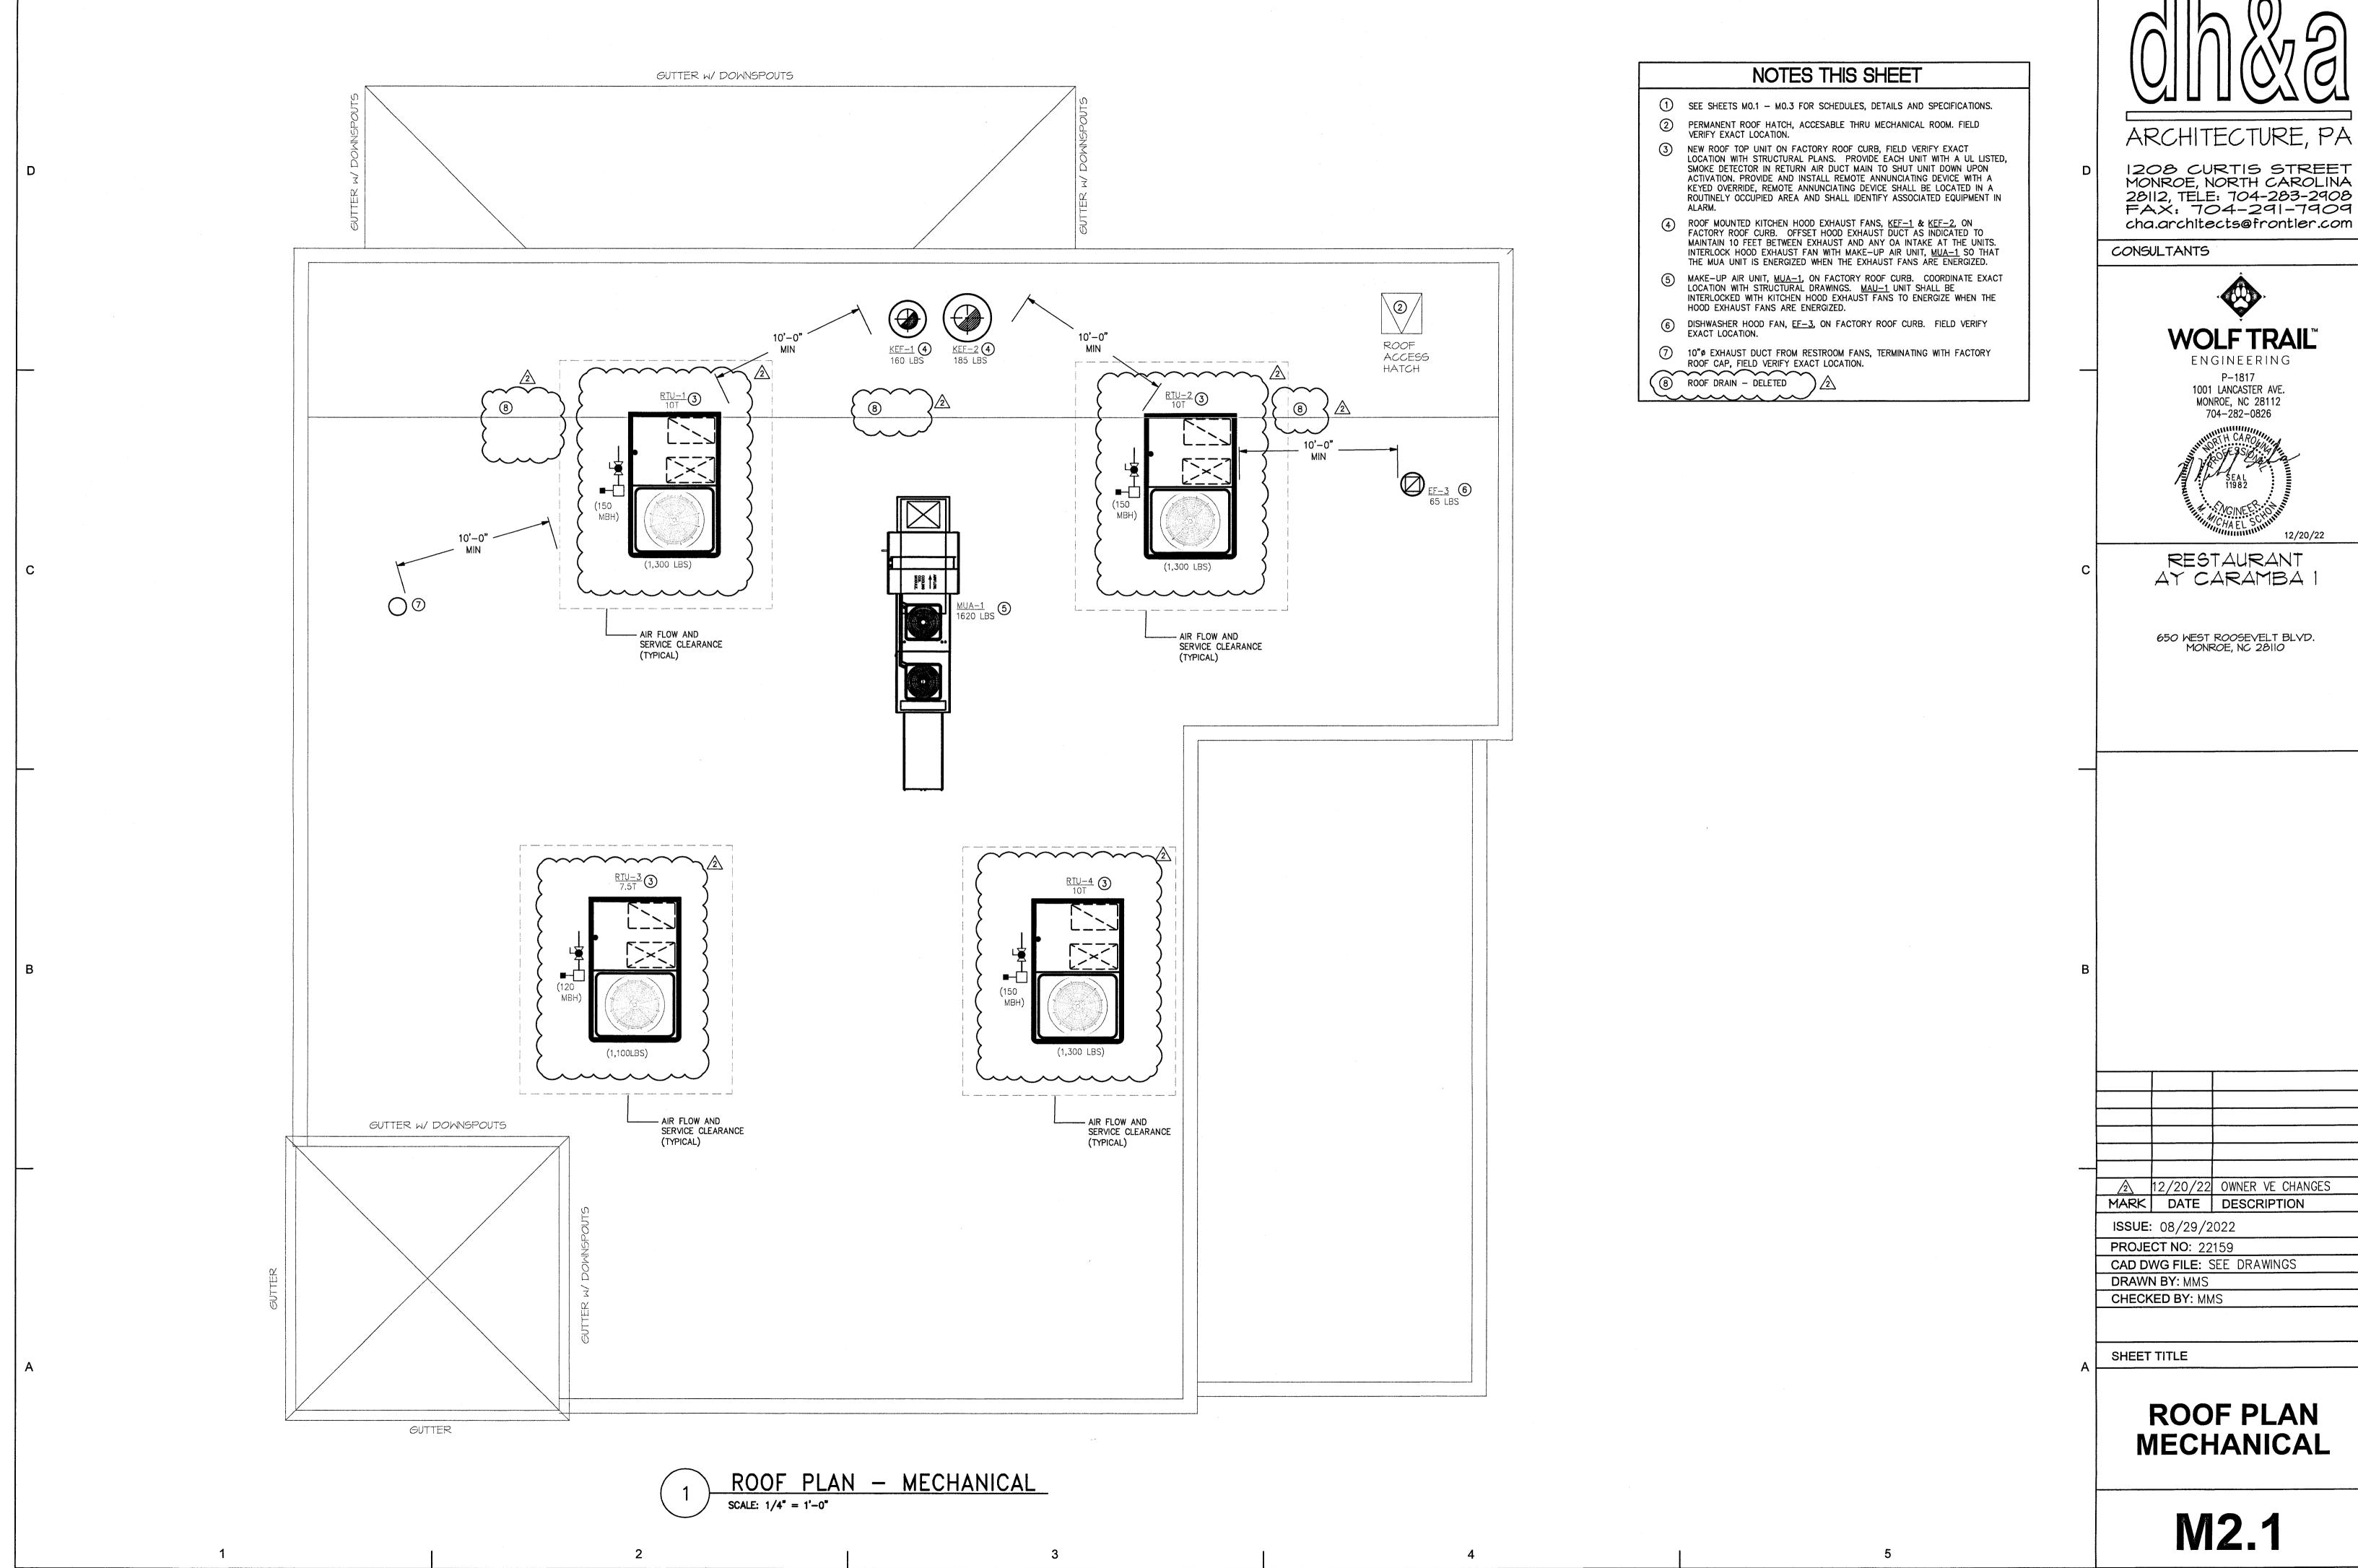


28112, TELE: 704-283-2908 FAX: 704-291-7909

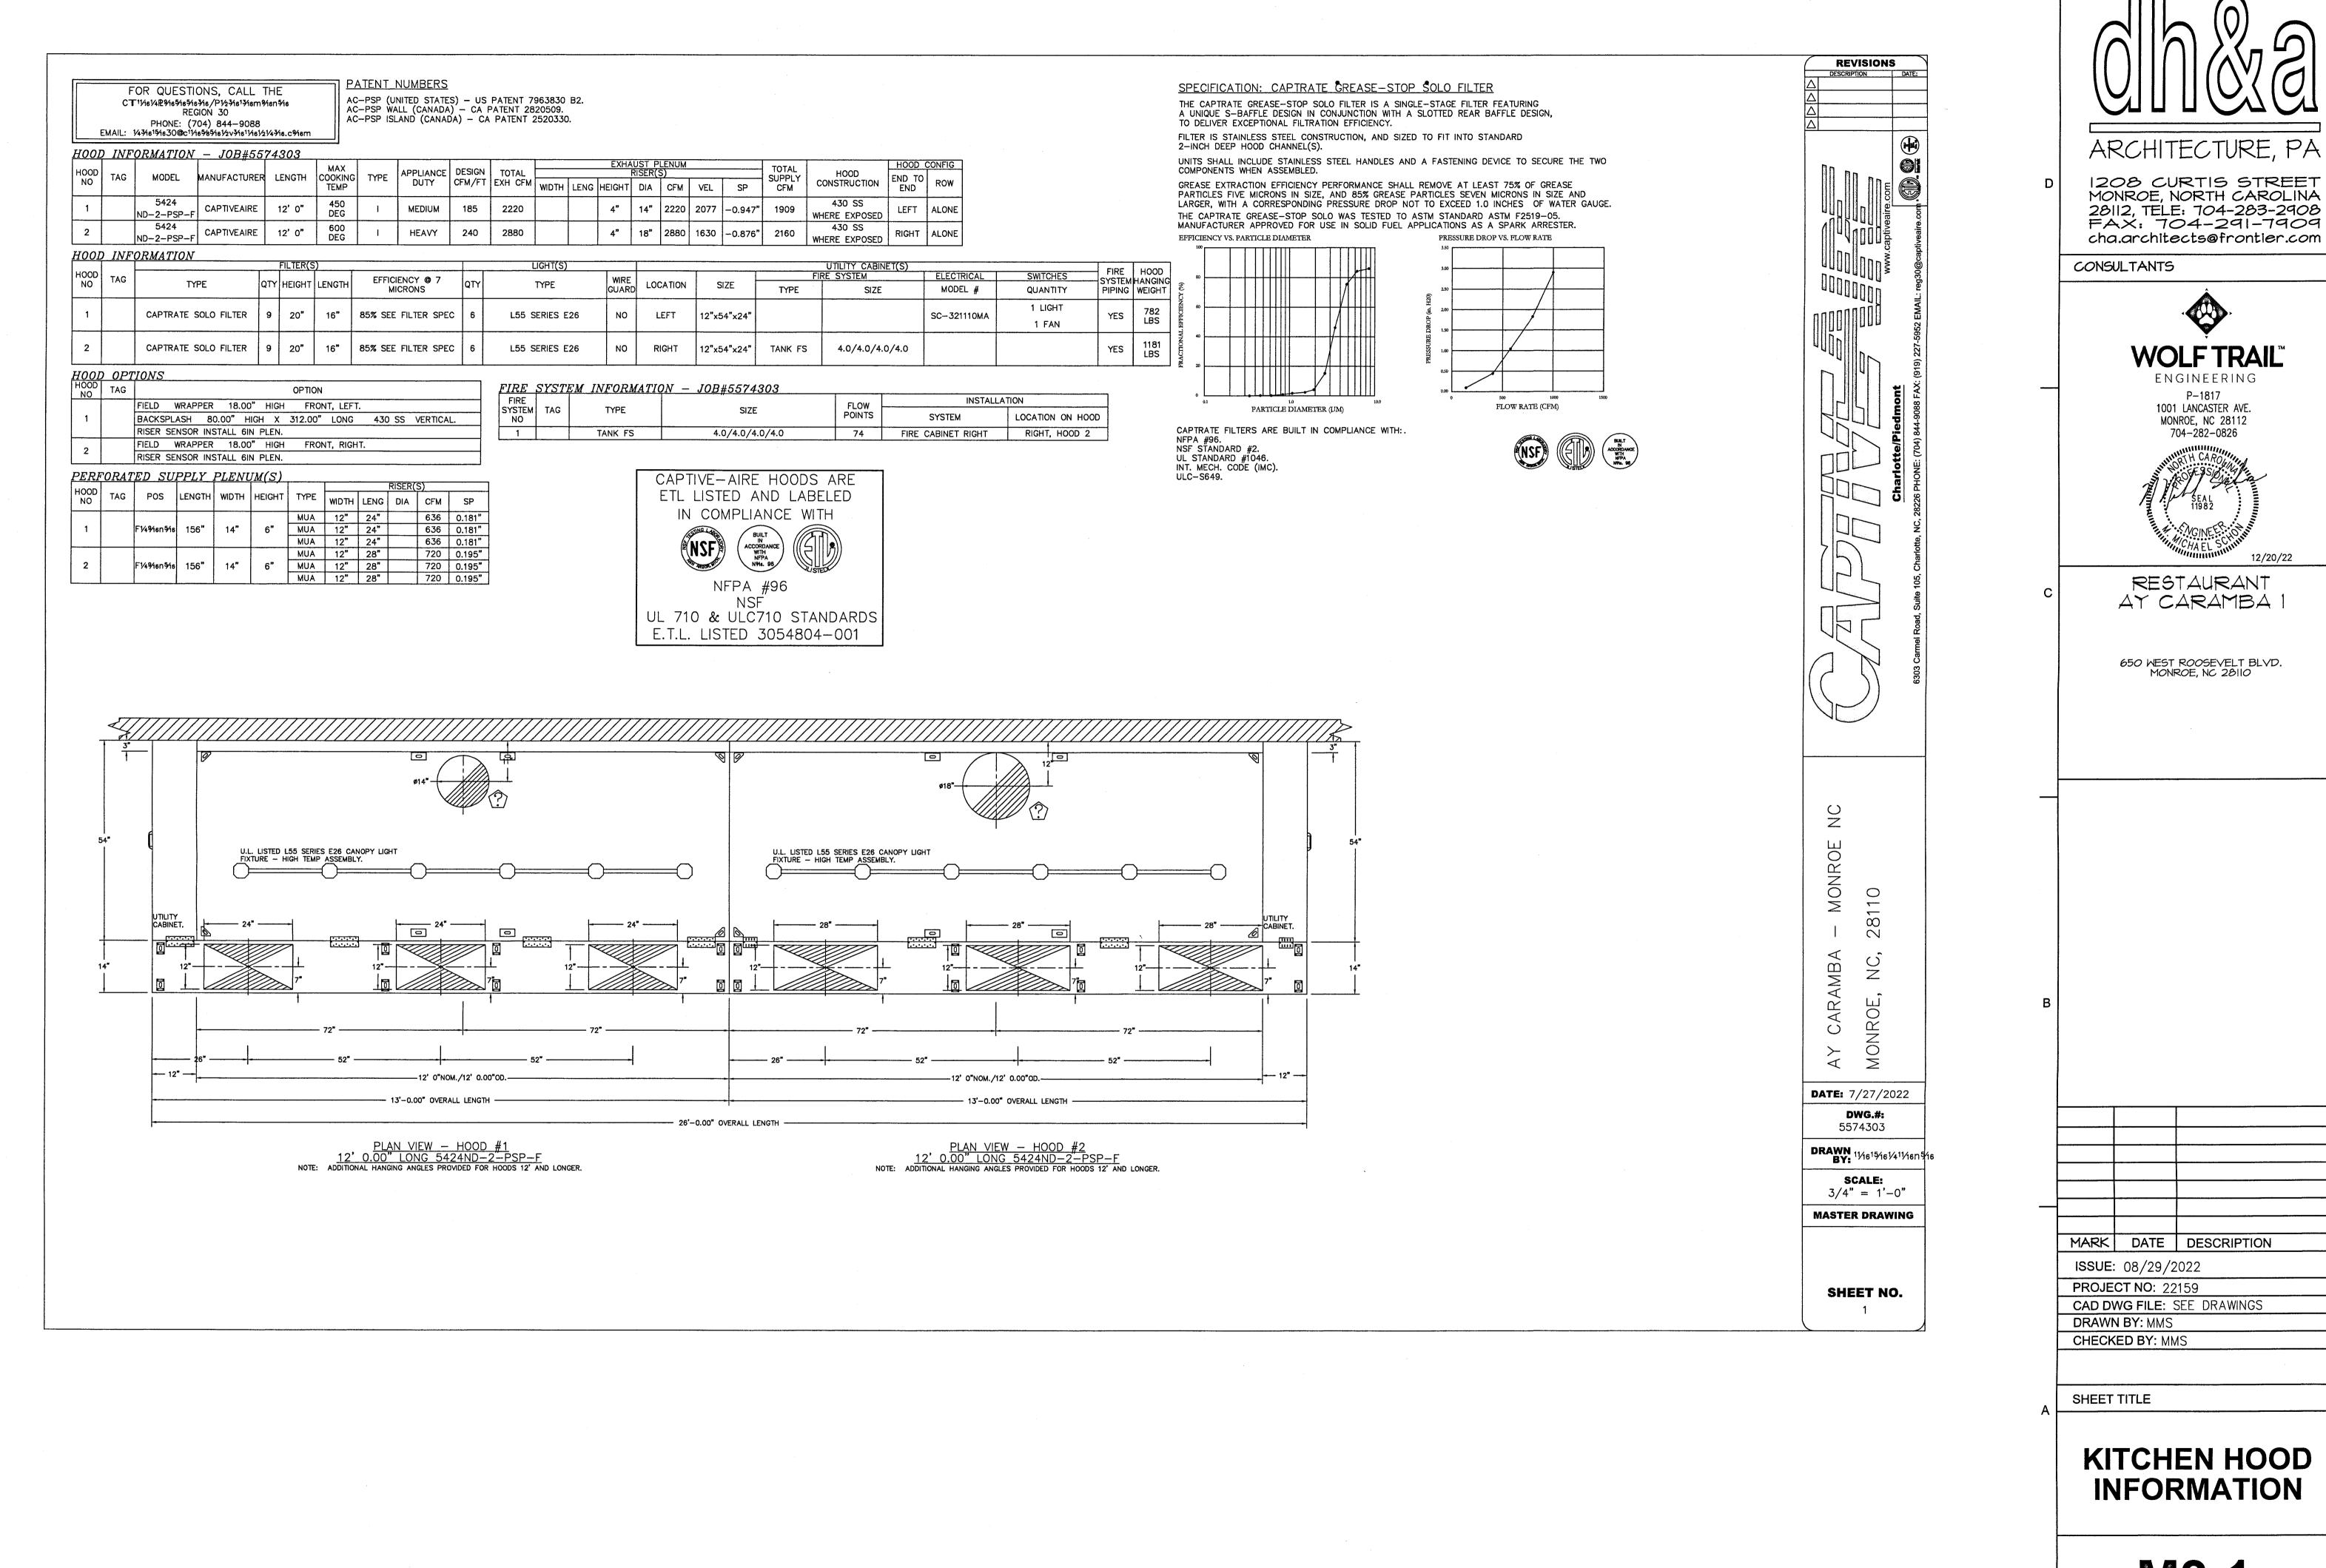


1208 CURTIS STREET MONROE, NORTH CAROLINA 28112, TELE: 704-283-2908 FAX: 704-291-7909 cha.architects@frontier.com



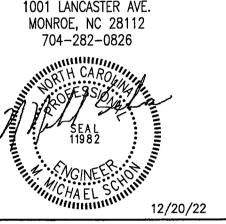

RESTAURANT AY CARAMBA


KITCHEN HOOD INFORMATION

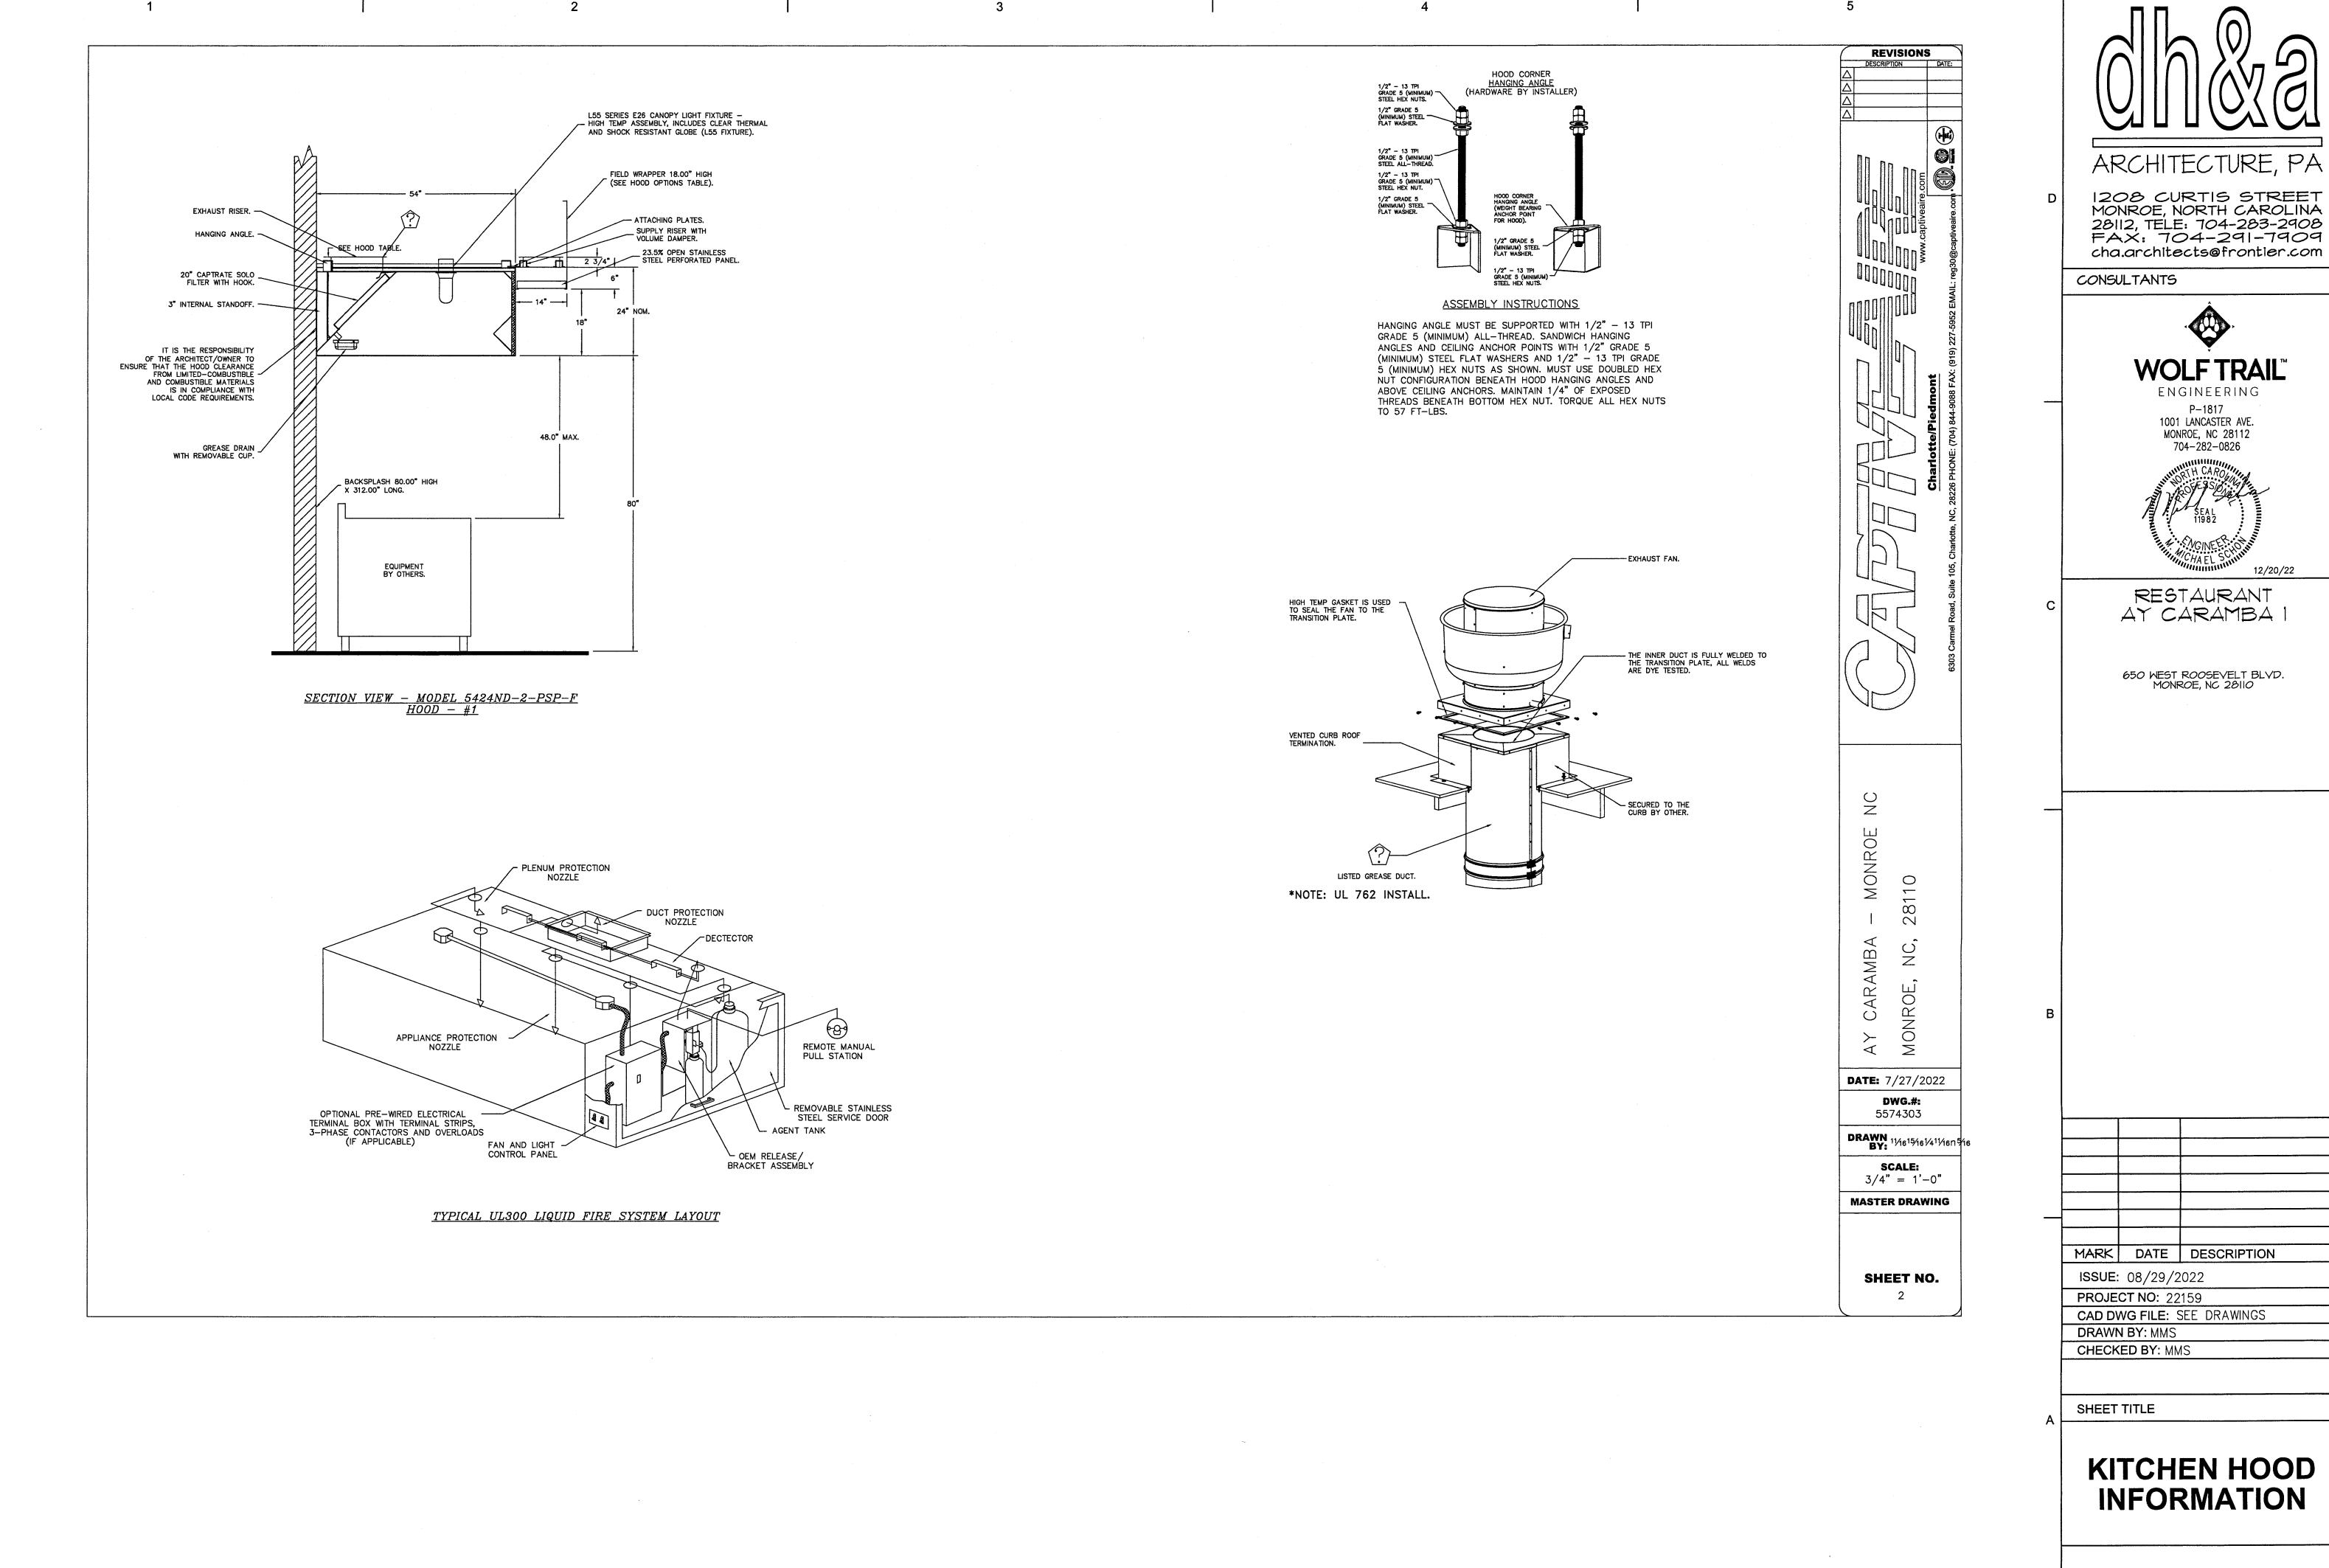

authorization does not permit a
City, State or Federal La
s Examiner:
Date: 04/06/2023

1208 CURTIS STREET MONROE, NORTH CAROLINA 28112, TELE: 704-283-2908 FAX: 704-291-7909

KITCHEN HOOD

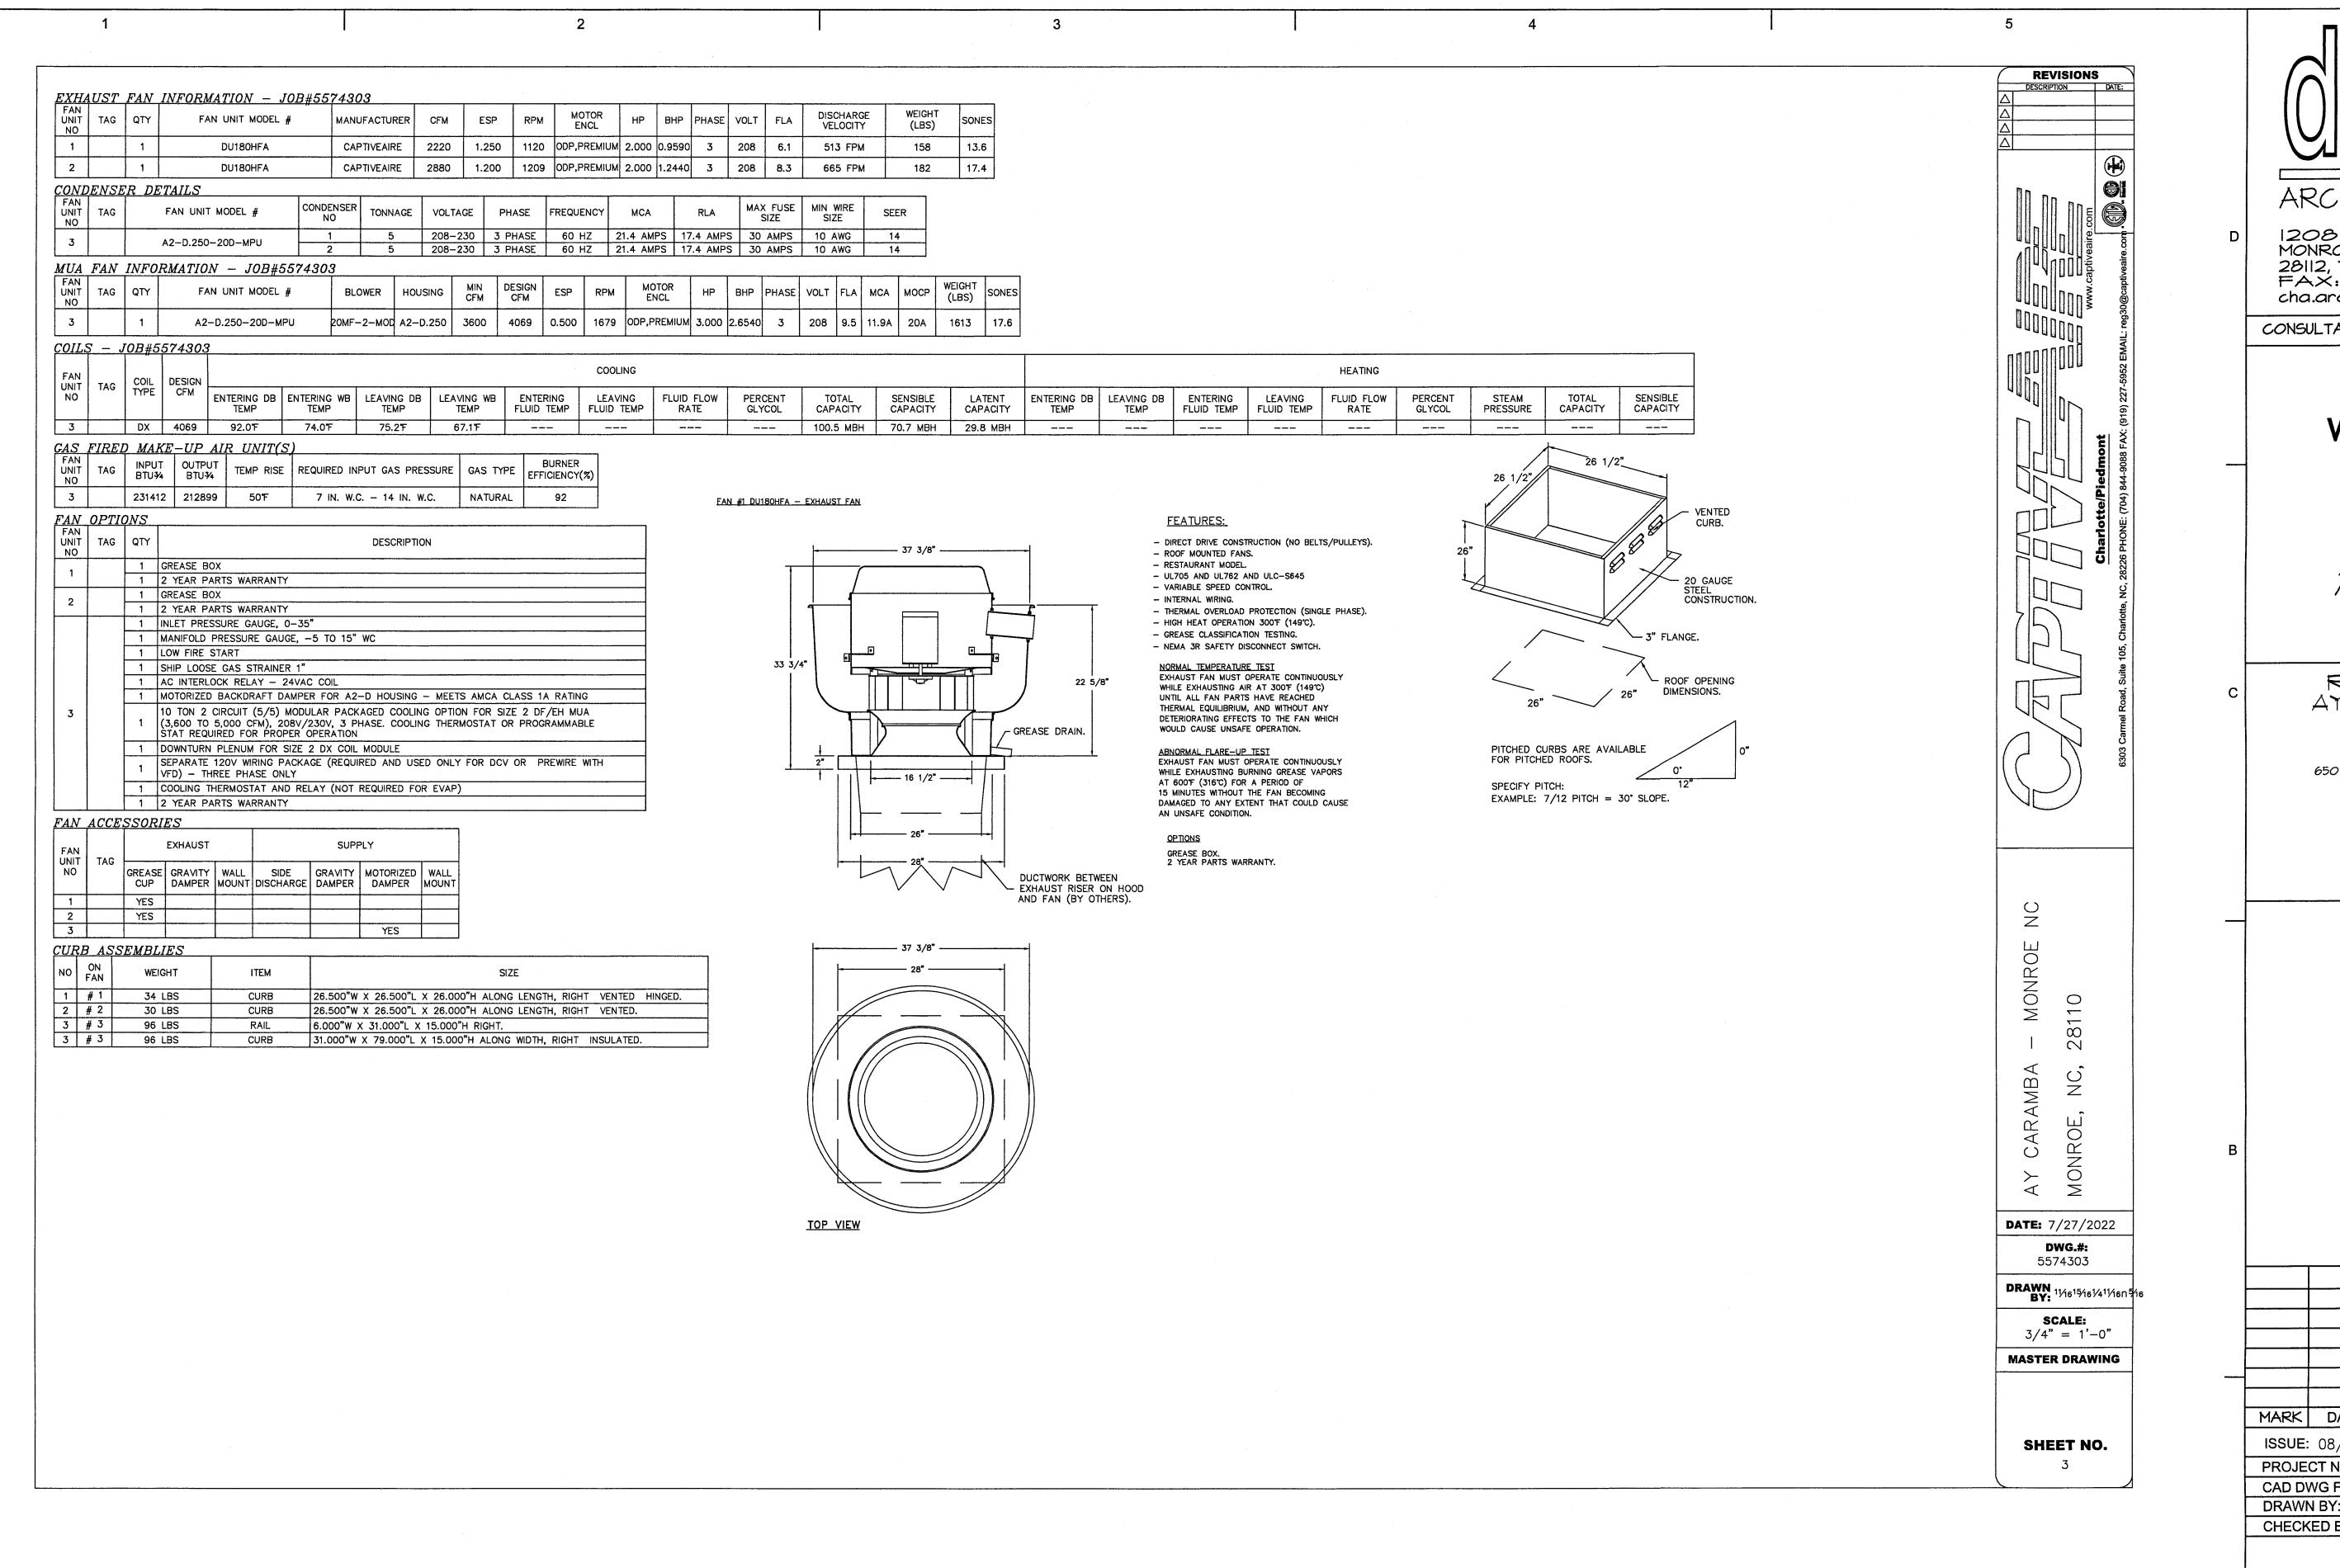


ARCHITECTURE, PA

1208 CURTIS STREET MONROE, NORTH CAROLINA 28112, TELE: 704-283-2908 FAX: 704-291-7909 cha.architects@frontier.com

CONSULTANTS



P-1817 1001 LANCASTER AVE. MONROE, NC 28112 704-282-0826

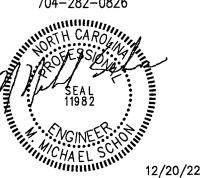


RESTAURANT AY CARAMBA


650 WEST ROOSEVELT BLVD. MONROE, NC 28110

MARK DATE DESCRIPTION **ISSUE**: 08/29/2022 PROJECT NO: 22159 CAD DWG FILE: SEE DRAWINGS **DRAWN BY: MMS CHECKED BY: MMS** 

KITCHEN HOOD INFORMATION


SHEET TITLE

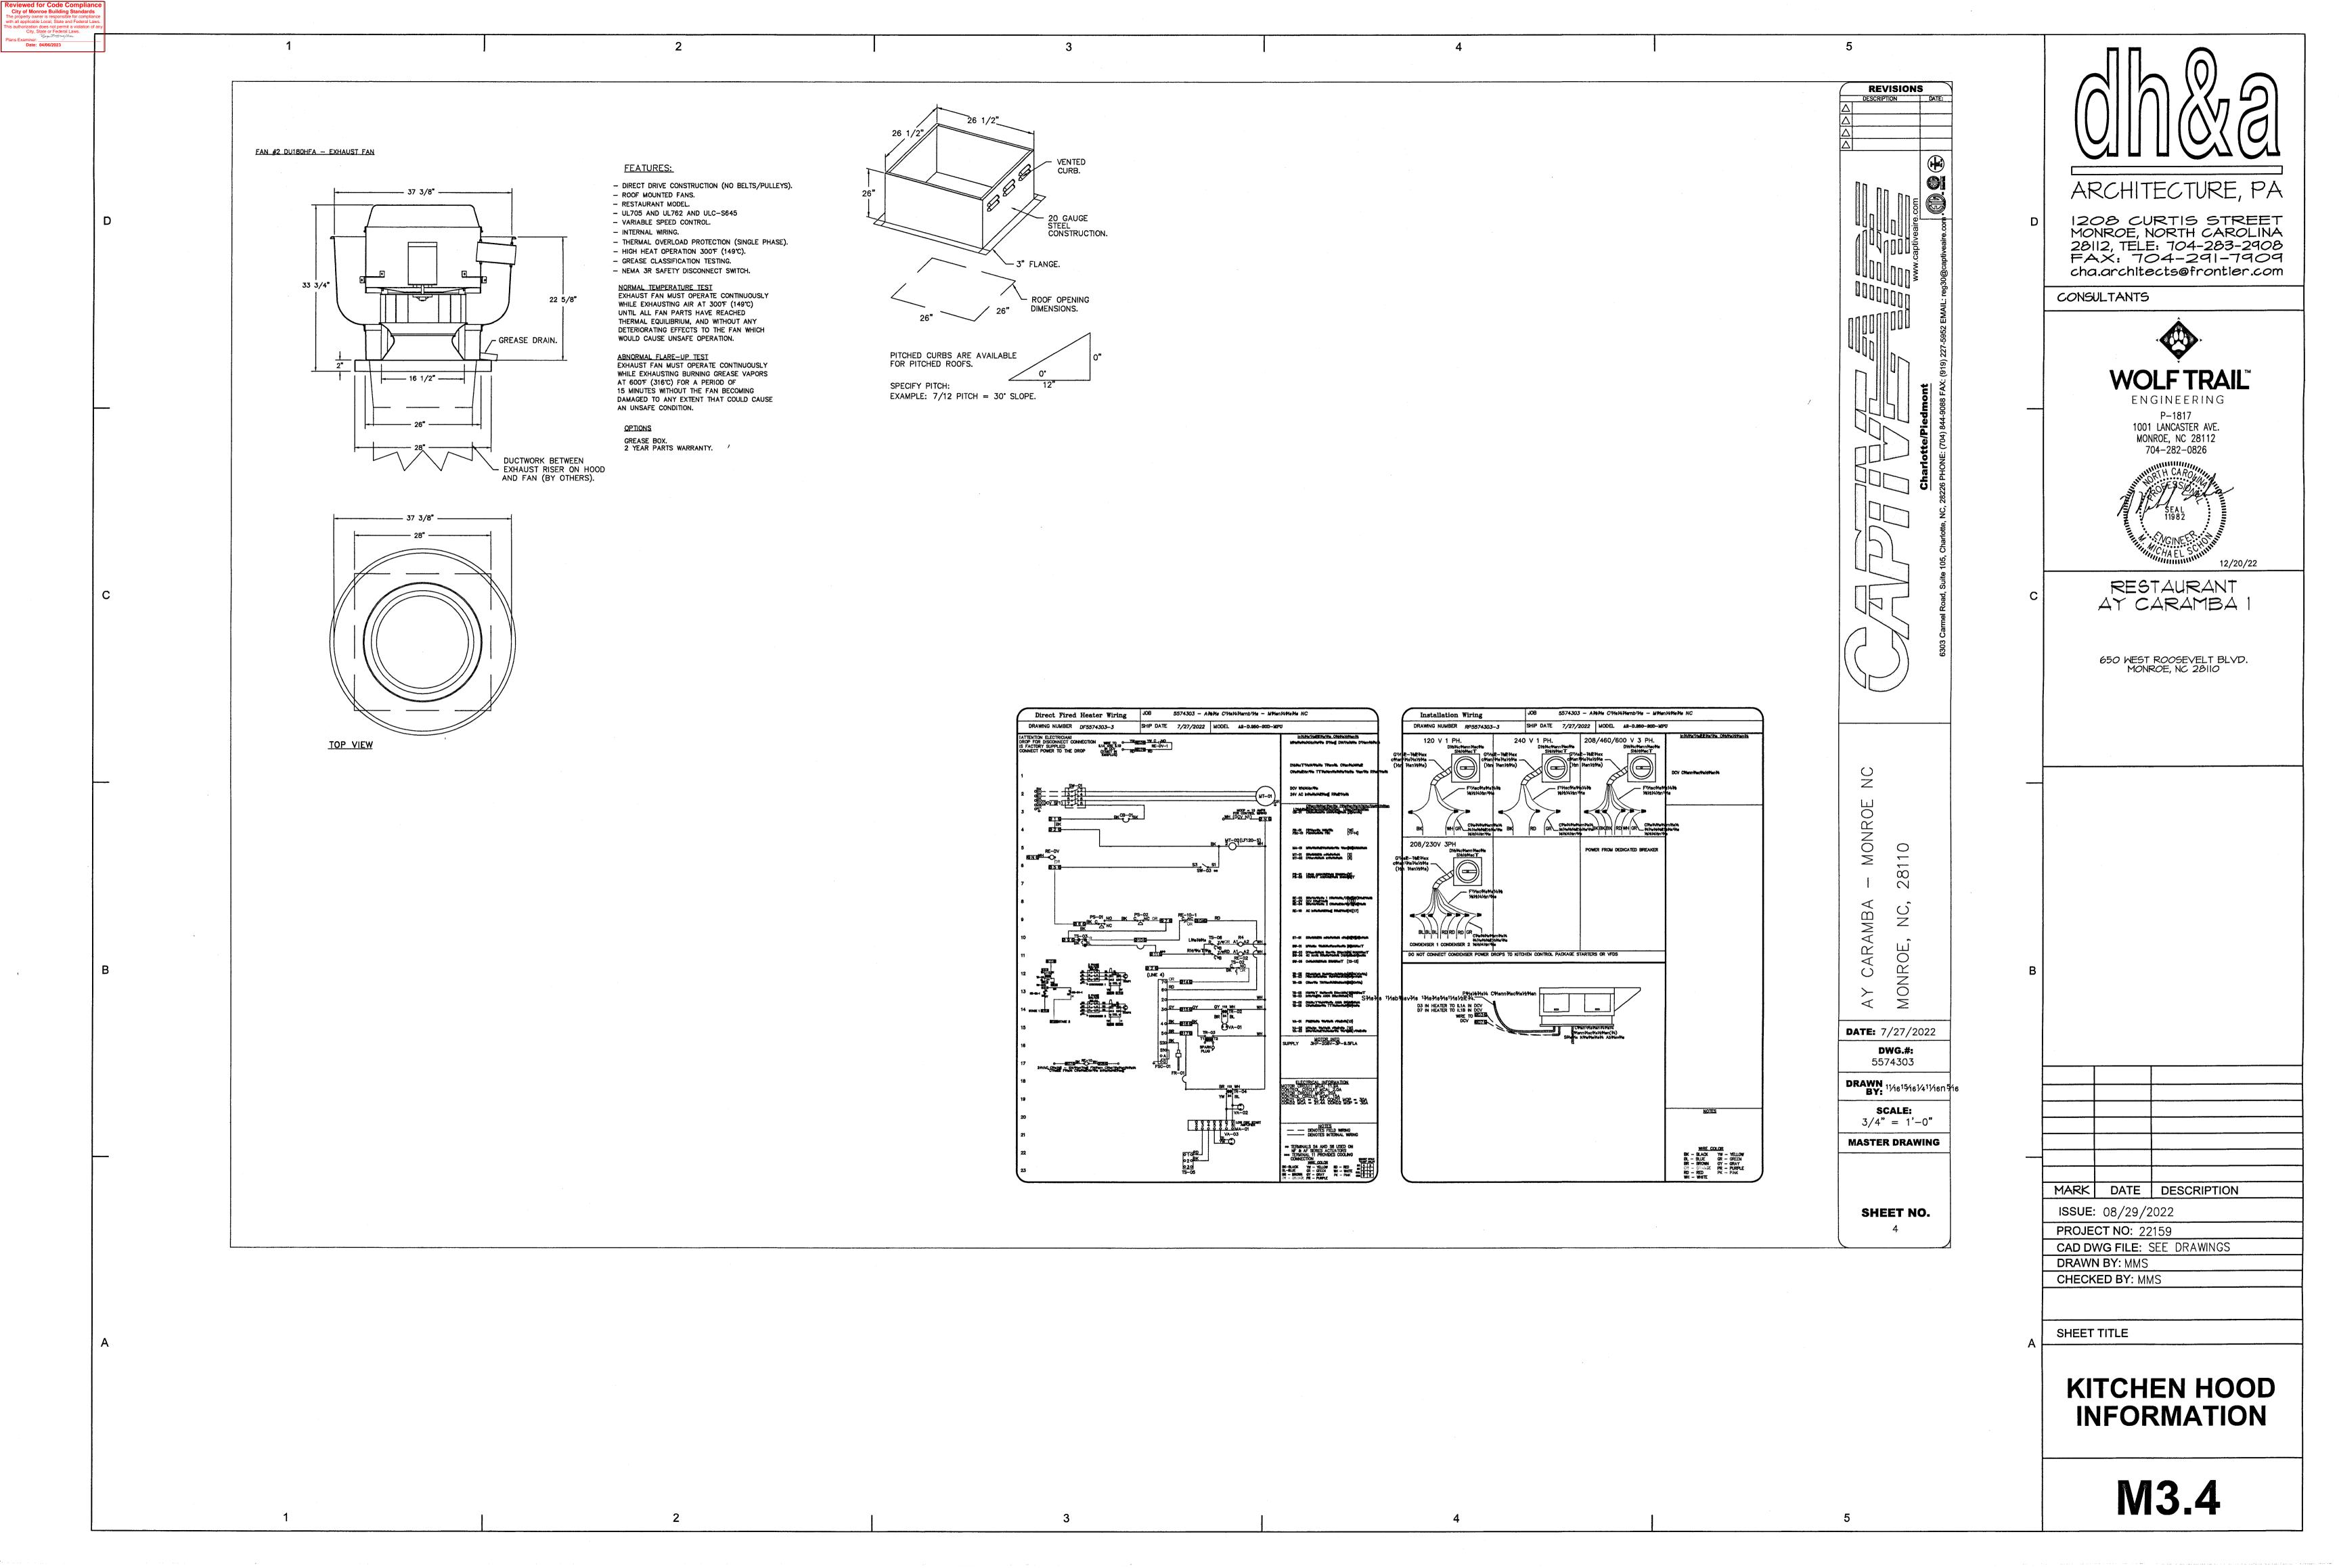


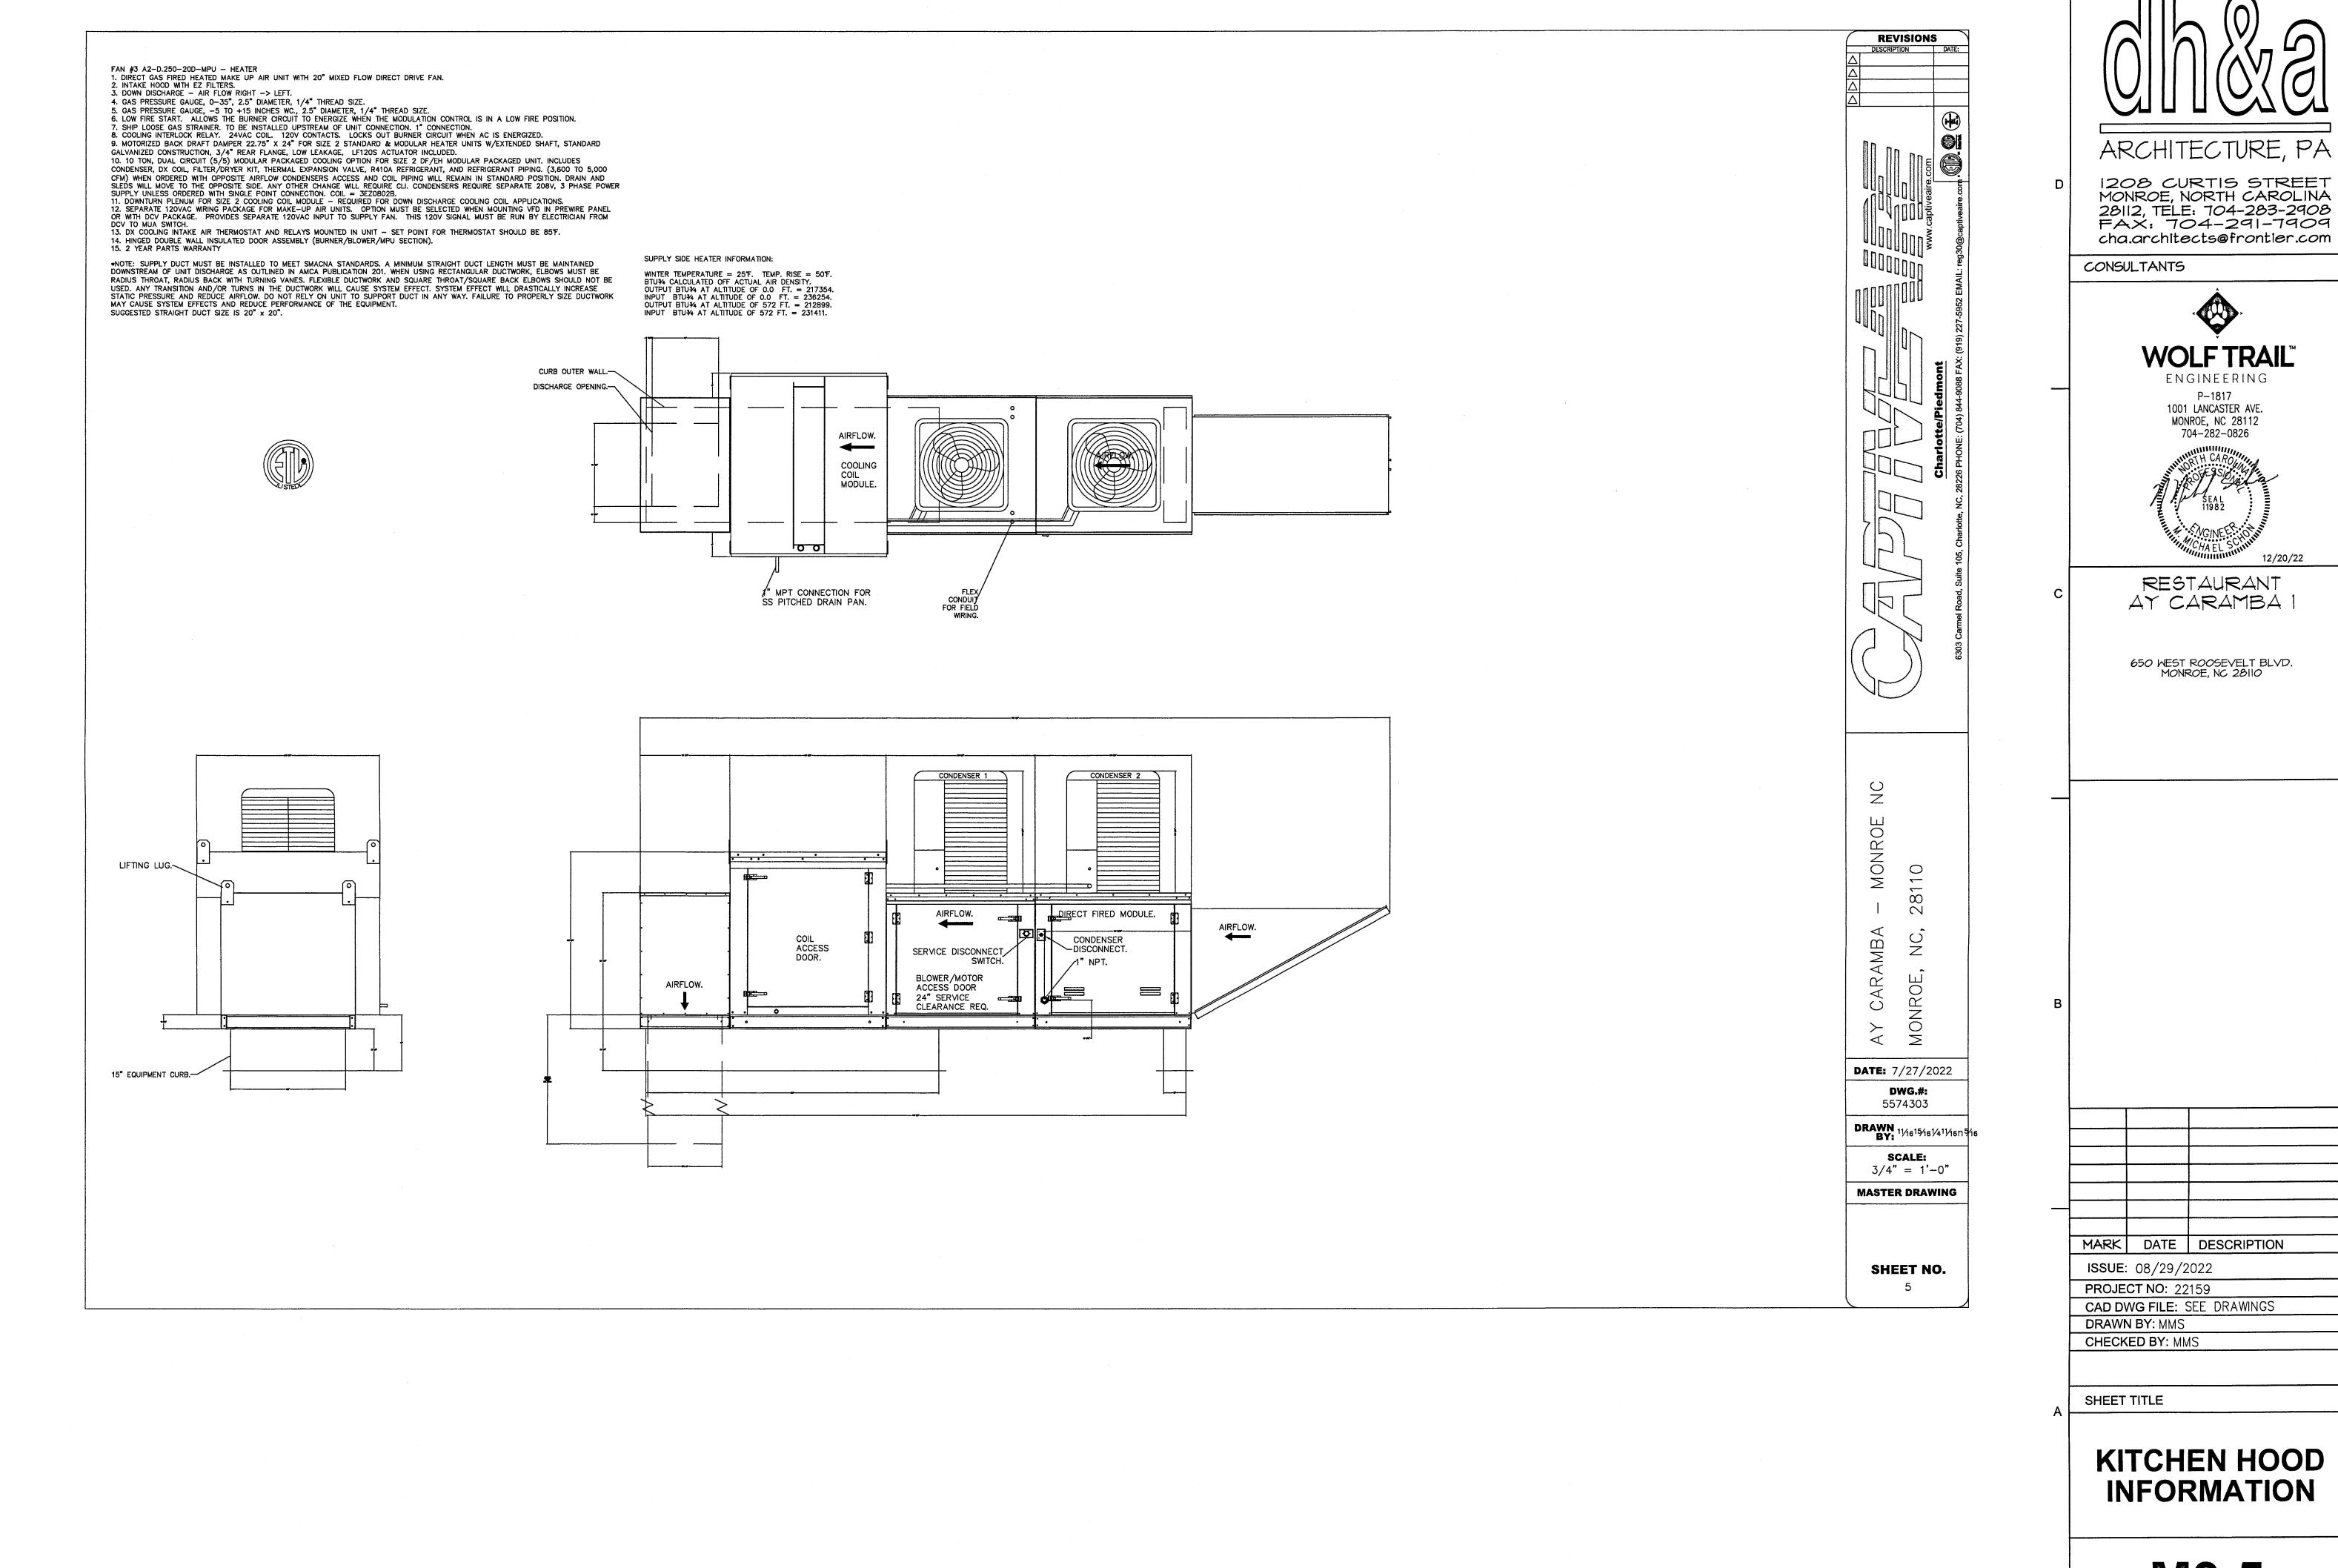



Examiner: 04/06/2023




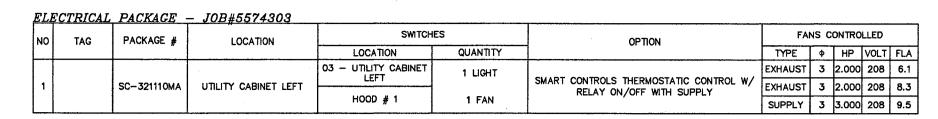


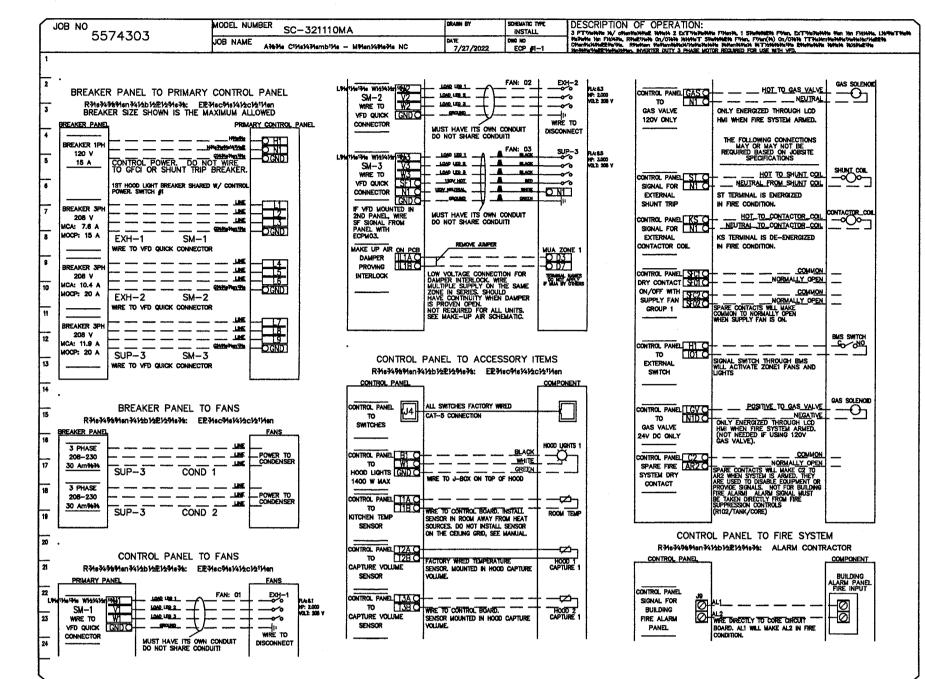

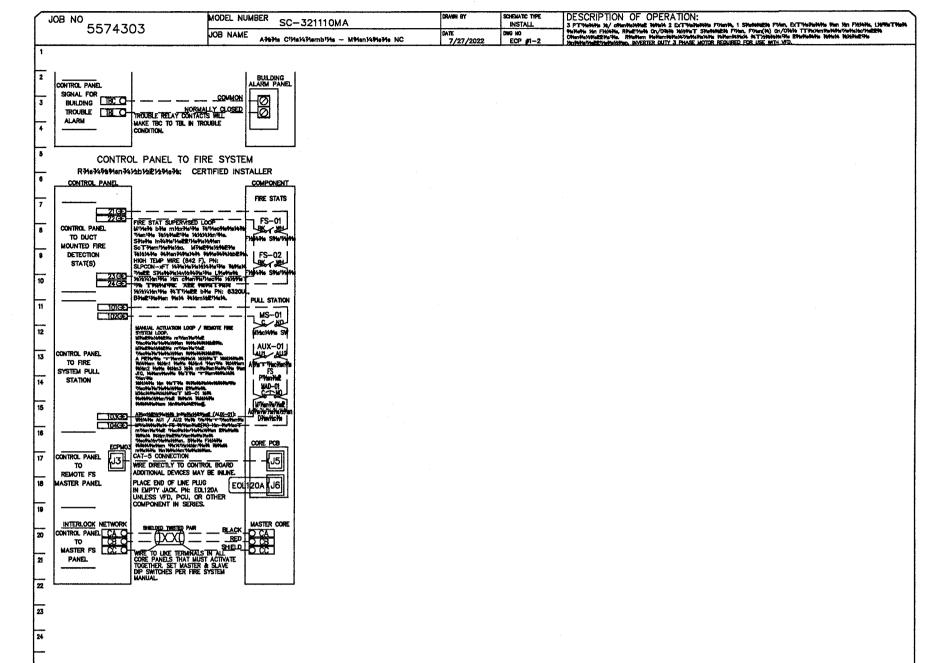

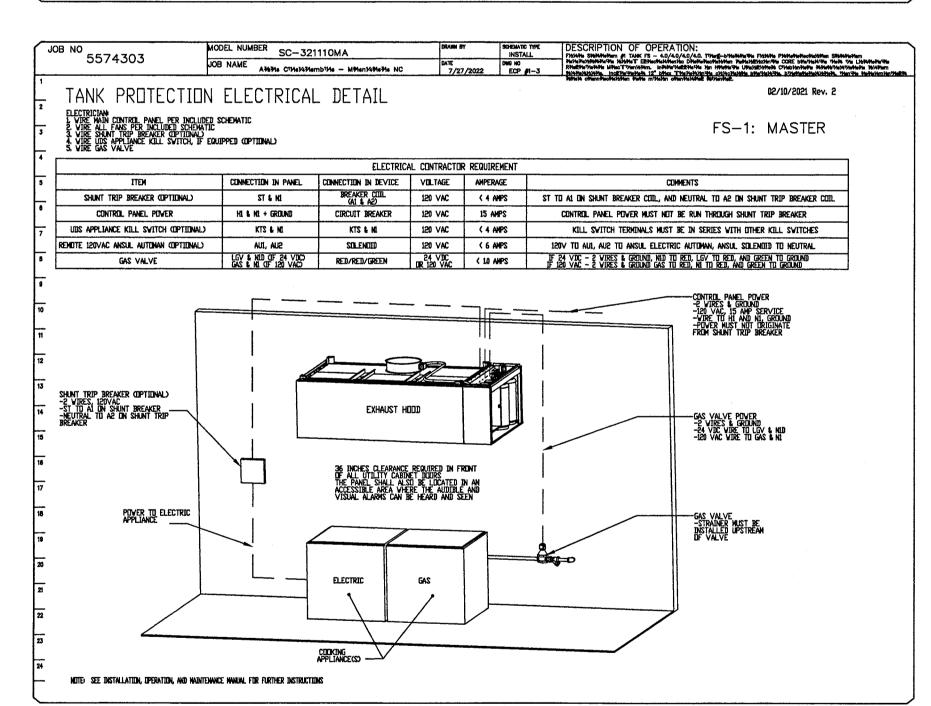

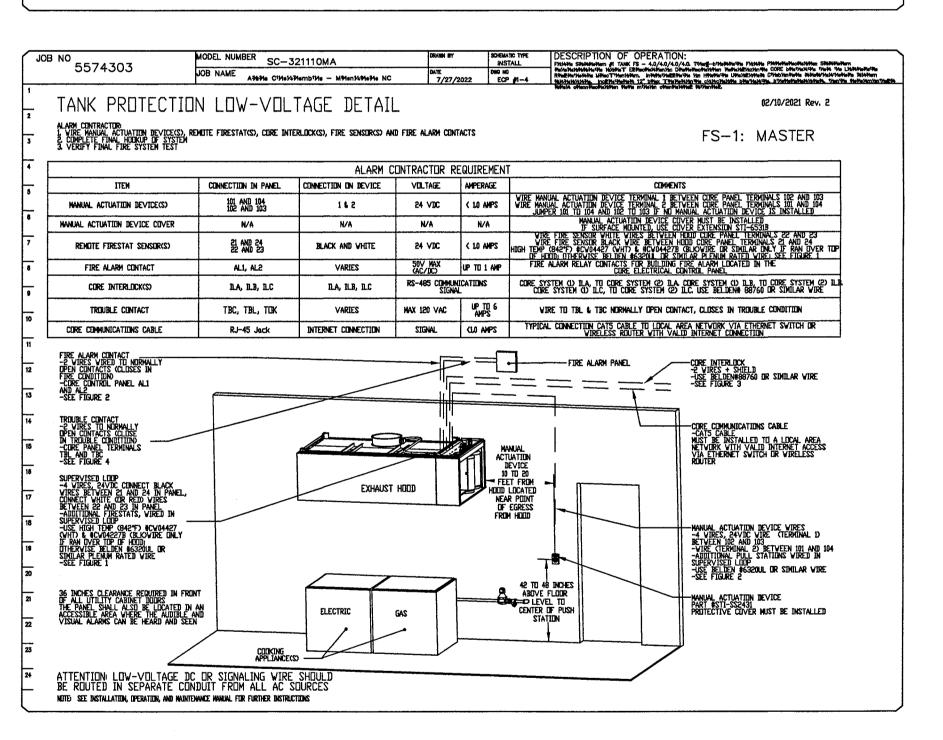

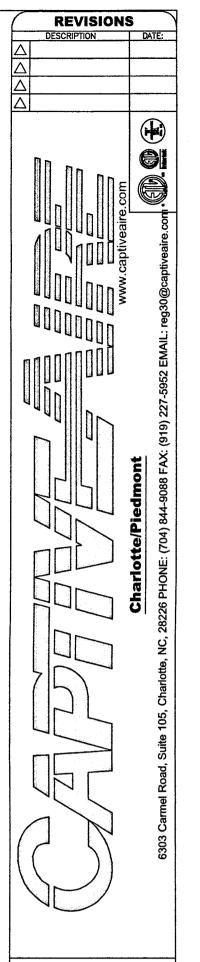

AY CARAMBA – MONROE NC

MONROE, NC, 28110


28110

DRAWN 11/16/15/16/14/11/16n 5/16

SCALE:
3/4" = 1'-0"


MASTER DRAWING

SHEET NO.

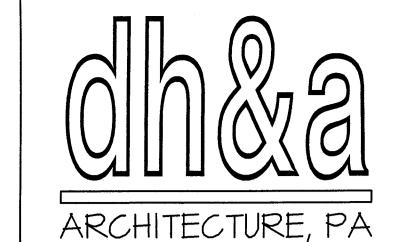

1208 CURTIS STREET MONROE, NORTH CAROLINA 28112, TELE: 704-283-2908 FAX: 704-291-7909 cha.architects@frontier.com

CONSULTANTS

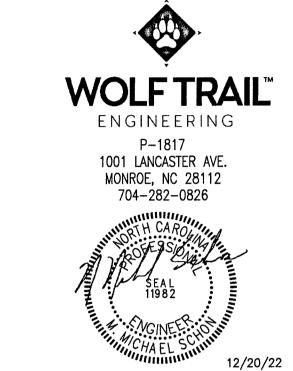

RESTAURANT AY CARAMBA

650 WEST ROOSEVELT BLVD. MONROE, NC 28110

MARK DATE DESCRIPTION

ISSUE: 08/29/2022

PROJECT NO: 22159


CAD DWG FILE: SEE DRAWINGS


DRAWN BY: MMS


CHECKED BY: MMS


KITCHEN HOOD INFORMATION

SHEET TITLE

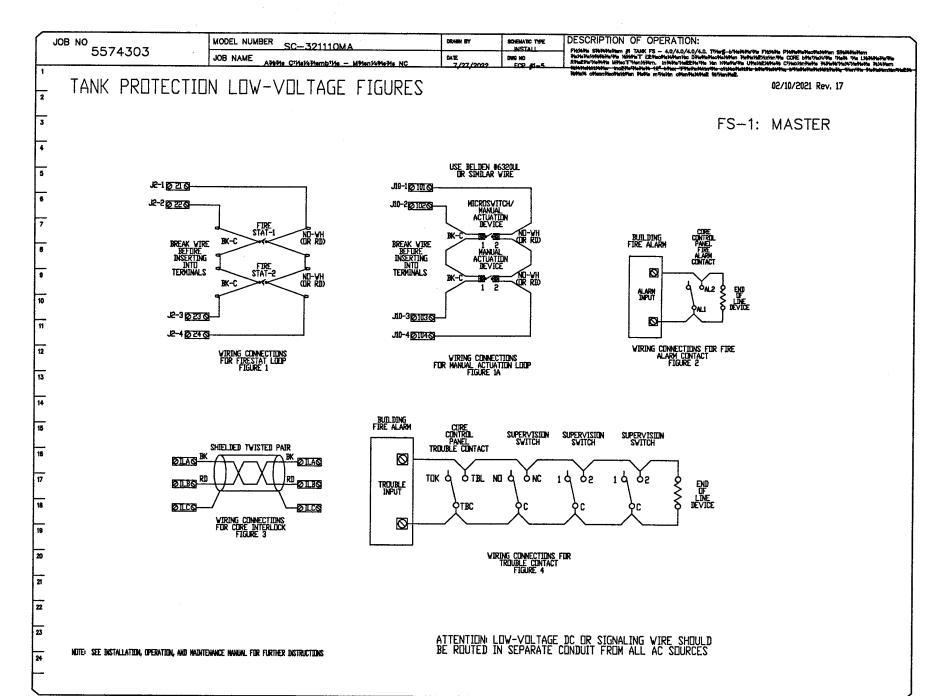

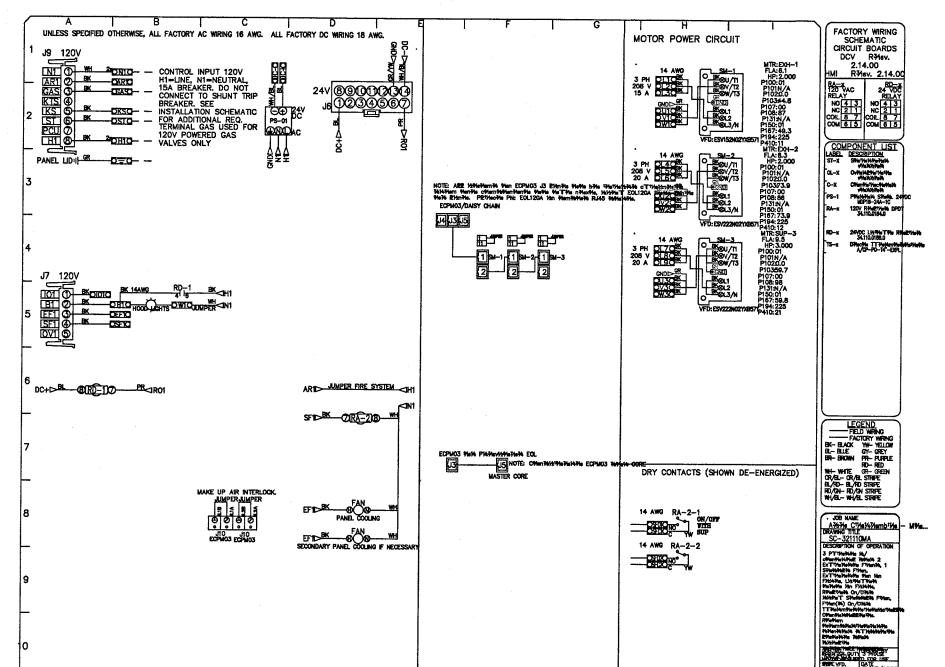

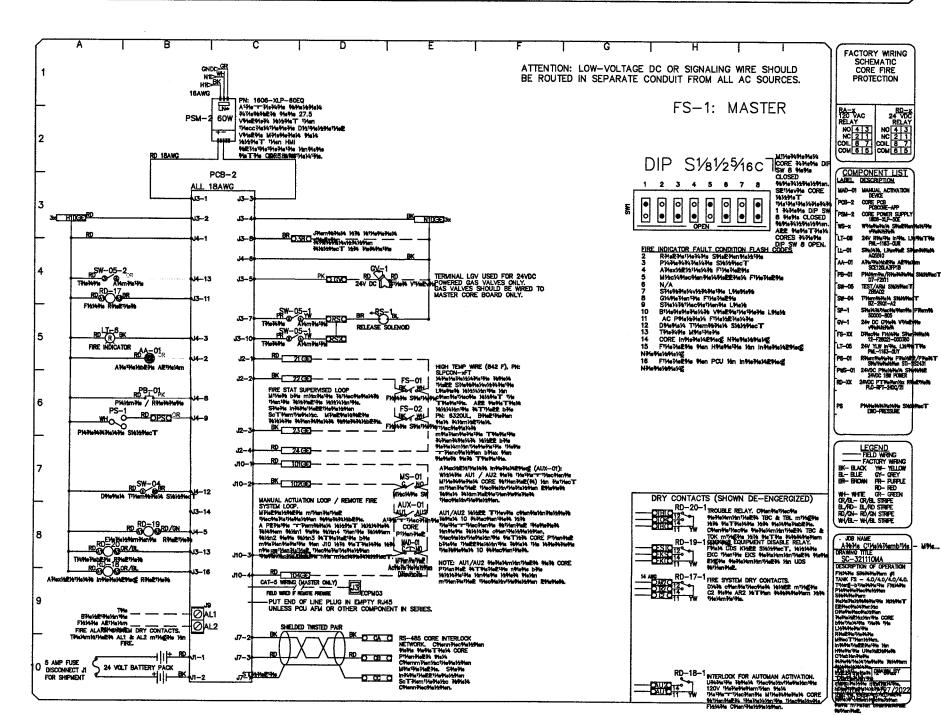

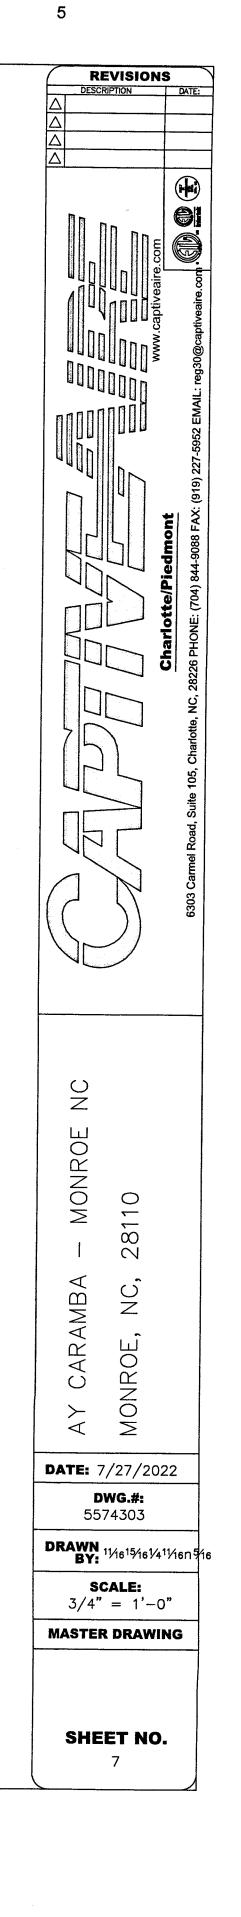


ARCHITECTURE, PA

1208 CURTIS STREET MONROE, NORTH CAROLINA 28112, TELE: 704-283-2908 FAX: 704-291-7909

cha.architects@frontier.com

CONSULTANTS



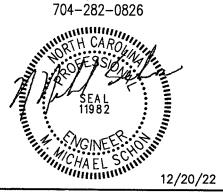

RESTAURANT AY CARAMBA 1

650 WEST ROOSEVELT BLVD. MONROE, NC 28110

MARK DATE DESCRIPTION

ISSUE: 08/29/2022

PROJECT NO: 22159

CAD DWG FILE: SEE DRAWINGS

DRAWN BY: MMS

CHECKED BY: MMS

KITCHEN HOOD INFORMATION

SHEET TITLE