PLUMBING SCHEDULE

DRAWING CODE	FIXTURE		DESCRIPTION	MANUFACTURER	MODEL	NOTES	PIPE SIZE			
							CW	HW	WASTE	VENT
WC1	TANK TYPE WATER CLOSET, FLOOR MTD, ADA	BOWL	17" HIGH BOWL, ELONGATED, V.C., 1.6 GPF, WHITE FINISH	AMERICAN STANDARD	215AA.004	5,8	1/2"	-	3"	2"
		SEAT	OFLC w/ SELF-SUSTAINING S.S. CHECK HINGE	OLSONITE	95C					
LAV1	COUNTERTOP LAVATORY, ADA	BOWL	INTEGRAL WITH COUNTERTOP- FURN. BY G.C.	-	-	2,4,5	1/2"	1/2"	2"	2"
		FAUCET	4" CENTERSET, TWO HANDLE, 1.20GPM@60PSI, THREE HOLE MOUNT, 1/4 TURN HANDLE STOPS V.P.	DELTA	2538-TP-DST					
		DRAIN	POP-UP	DELTA						
		MIXING VALVE	LEAD FREE THERMOSTATIC MIXING VALVE - SETPOINT = 105°F INSTALL ON HOT WATER SUPPLY, ASSE 1070	CASH-ACME	HG-135					
SH1	JOB-BUILT SHOWER, ADA	ENCLOSURE	JOB-BUILT BY G.C. W/ GRAB BARS per ADA	-	-	12	1/2"	1/2"	2"	2"
		VALVE	PRESS. BAL., ARM/, 2.0 GPM HEAD, 105°F MAX.	SYMMONS	S-96-1					
		VALVE	PRESS. BAL., HAND SPRAY w/ VACUUM BREAKER, 24" SLD. BAR, 105° MAX.	SYMMONS	S-96-300-B30-L-V					
		DRAIN	6" DIA. NKL. BRZ.	JR SMITH	2000					
SK1	1-COMPARTMENT COUNTERTOP SINK, ADA	BOWL	15x15x6 18 GA S.S.	ELKAY	BCR153	2,3,4,5	1/2"	1/2"	2"	2"
		FAUCET	GOOSENECK,WRISTBLADE HANDLE	DELTA	B28910LF					
		DRAIN	CRUMBCUP STRAINER	ELKAY	LK35					
		MIXING VALVE	LEAD FREE THERMOSTATIC MIXING VALVE - SETPOINT = 105°F INSTALL ON HOT WATER SUPPLY, ASSE 1070	CASH-ACME	HG-135					
SK2	2-COMPARTMENT COUNTERTOP SINK, ADA	BOWL	33x21x5.5, 18 GA S.S.	ELKAY	LRAD3321	2,3,4,5	1/2"	1/2"	2"	2"
		FAUCET	GOOSENECK,WRISTBLADE HANDLE, V.P. LAMINAR FLOW AERATOR	DELTA	26T3925					
		DRAIN	(2) CRUMBCUP STRAINER	ELKAY	LK35					
		MIXING VALVE	LEAD FREE THERMOSTATIC MIXING VALVE - SETPOINT = 105°F INSTALL ON HOT WATER SUPPLY, ASSE 1070	CASH-ACME	HG-135					
BSK1	BEAUTY SINK	BOWL	19x19x8.75 CAST IRON	BELVEDERE	3800	2,3,5,10	1/2"	1/2"	2"	2"
		FAUCET	FAUCET, SPRAY, STRAINER, VACUUM BREAKER	BELVEDERE	INCLUDED					
		DRAIN	STRAINER	BELVEDERE	INCLUDED					
		MIXING VALVE	LEAD FREE THERMOSTATIC MIXING VALVE - SETPOINT = 105°F INSTALL ON HOT WATER SUPPLY, ASSE 1070	CASH-ACME	HG-135					
BT1	TUB	TUB	66x32 E.C.I, INTEGRAL APRON, WHITE FINISH	AMERICAN STANDARD	2696	10	1/2"	1/2"	2"	2"
		VALVE	PRESS. BAL.w/ DIVERTER., ARM/, 2.0 GPM HEAD, HAND SPRAY w/ VACUUM BREAKER, 24" SLD. BAR, 105°F, MAX.	SYMMONS	S-96-600					
		DRAIN	NKL. BRZ.	AMERICAN STANDARD	1583.470					
WPT1	WHIRLPOOL TUB	FIXT	BY OTHERS.	ARJO	PARKER BATH	7	3/4"	3/4"	MATCH	-
PED 1	PEDICURE CHAIR	FIXT	BY OTHERS	BELVEDERE	ALEXANDRIA	11	3/4"	3/4"	MATCH	-
CS1	CLINICAL SINK W/ BEDPAN WASHER	BOWL	18" HIGH BOWL,V.C.,	AMERICAN STANDARD	9504.010					
		FAUCET	BEDPAN CLEANER	AMERICAN STANDARD	7880.024		1/2"			
		FAUCET	EXPOSED YOKE WALL-MOUNT UTILITY FAUCET	AMERICAN STANDARD	8345.119		1/2"	1/2"	4"	2"
		FLUSH VALVE	CHROME PLATED BRASS	SLOAN	117 HYVO		1"			
		BASE	TERRAZZO BASE	STERN WILLIAMS	1028					
MS1	MOP SINK	BASIN	28x28x12 MOLDED STONE w/ GRID STRAINER	FIAT	TSBCR-1000	9	1/2"	1/2"	2'	2"
		FAUCET	WALL MOUNT, V.P.	FIAT	830-AA					
		ACCESSORIES	HOSE/BRACKET, MOP HANGER	FIAT	832-AA, 889-CC					
LS1	WALL MOUNT LAUNDRY SINK	SINK	FIBERGLASS WALL MOUNT	FIAT	L-1	1,2,5,9,14	1/2"	1/2"	2"	2"
		FAUCET	DECK MOUNT, LEVER HANDLES, V.B.	DELTA	2121					
SS1	SERVICE SINK	SINK	24X20 ENAMELED CAST IRON, WALL HANGER, RIM GUARD, 8"CENTER DRILL	AMERICAN STANDARD	7695.008	9	1/2"	1/2"	3"	2"
		FAUCET	BRASS CONSTRUCTION, ROUGH CHROME FINISH, INTEGRAL VACUUM BREAKER, 3/4"THREADED SPOUT, SERVICE STOPS, WALL MOUNT, VANDAL RESISTANT, LEVER HANDLES	MOEN	8230					
		ACCESSORIES	CAST IRON P-TRAP STANDARD TO WALL AND STRAINER FOR 3" IRON PIPE	AMERICAN STANDARD	7798.03					
EWC1	WALL HUNG WATER COOLER, ADA	FIXT	SPLIT LEVEL, S.S. TOP, BOTTLE FILLING STATION, 8 GPH @ 50/80/90, 120V/1PH	ELKAY	LMABFTL8WS	1,5	1/2"	-	2"	2"
		HANGER	WALL MOUNTED	-	-					
EWH1	ELECTRIC WATER HEATER, 6 GAL	FIXT	GLASS-LINED TANK, 1500W, 120V/1PH	A.O. SMITH	DEL-6		3/4"	3/4"	-	-
		EXP TANK	2 GAL DIAPHRAGM		PMC-2				-	-
EW1	WALL MOUNT EYE WASH	FIXT	STAINLESS STEEL BOWL	BRADLEY	S19-220T		1/2"	1/2"	2"	2"
		FIXT	EMERGENCY THERMOSTATIC MIXING VALVE	BRADLEY	S19-2000		1/2"	1/2"	-	-
EW2	FAUCET MOUNTED PULL KNOB WASH	FIXT	SPOUT MOUNTED, PULL KNOB DIVERTER VALVE, FLOAT OFF DUST CAPS ON OUTLET HEADS	GUARDIAN	G1101	13	1/2"	1/2"	-	-
FCO	FLOOR CLEANOUT	FIXT	C.I. BODY, ADJUSTABLE, SCORIGATED, NICKEL BRONZE TOP	JR SMITH	4020		-	-	MATCH	-
WCO	WALL CLEANOUT	FIXT	ROUND S/S ACCESS COVER & SCREW, RECESS BRONZE THRD. PLUG	JR SMITH	4710		-	-	MATCH	-
FD1	FLOOR DRAIN	FIXT	C.I. BODY, MEMBRANE CLAMP, 6" DIA. NICKEL BRONZE TOP	JR SMITH	2000	6	-	-	MATCH	-
FD2	FLOOR DRAIN	FIXT	C.I. BODY, MEMBRANE CLAMP, 6" DIA. NICKEL BRONZE TOP	JR SMITH	2000		-	-	MATCH	-
FD3	FLOOR DRAIN	FIXT	C.I. BODY, MEMBRANE CLAMP, 9" DIA. NICKEL BRONZE TOP	JR SMITH	2005		-	-	6"	-
FS1	FLOOR SINK	FIXT	8x8x6 A.R.C.I. RECEPTOR, MEMBRANE CLAMP, DOME STRAINER, 1/2 GRATE	JR SMITH	3100		-	-	MATCH	-
FS2	FLOOR SINK	FIXT	12x12x8 A.R.C.I. RECEPTOR, MEMBRANE CLAMP, DOME STRAINER, 1/2 GRATE	JR SMITH	3150		-	-	MATCH	-
HB1	INTERIOR HOSE BIBB	FIXT	POLISHED CHROME, VACUUM BREAKER, WHEEL HANDLE, 3/4" HOSE THREAD	WOODFORD	24P		3/4"	-	-	-
HB2	EXTERIOR HOSE BIBB	FIXT	NON-FREEZE, ROUGH BRASS, VACUUM BREAKER, REMOVABLE HANDLE, 3/4" HOSE THREAD	WOODFORD	25CP		3/4"	-	-	-
OB1	ICE MAKER BOX	FIXT	POLYCARBONATE HOUSING w/ BRASS SHUTOFF VALVE; PROVIDE SHOCK ARRESTOR	OATEY	39145		1/2"	-	-	-
CW1	CAN WASH / CART WASH	BASIN	JOB-BUILT BY G.C.	-	-					
		FAUCET	NON-FREEZE, HOT -COLD	WOODFORD	HC-67		1/2"	1/2"	3"	2"
		DRAIN	MED. DUTY, 12" DIA. C.I. GRATE, SEDIMENT BUCKET	JR SMITH	2143					
GI1	GREASE INTERCEPTOR	FIXT	2000 GALLON CONCRETE INTERCEPTOR, AS APPORVED BY LOCAL JURISDICTION	-	-		-	-	4"	-
GI2	GREASE INTERCEPTOR	FIXT	430 GALLON CONCRETE INTERCEPTOR, AS APPROVED BY LOCAL JURSDICTION	-	-		-	-	4"	-
SI	SOLIDS INTERCEPTOR	FIXT	OUTDOOR POLYETHYLENE BASKET STYLE SOLIDS INTERCEPTOR; 52 GALLON CAPACITY	SCHIER	SI-50		-	-	4"	-
LI	LINT INTERCEPTOR	FIXT	OUTDOOR POLYETHYLENE BASKET STYLE LINT INTERCEPTOR; 100 GPM, 7 GALLON CAPACITY	STRIEM	AA-6		-	-	6"	-
CP1	HOT WATER RECIRC PUMP	FIXT	CARTRIDGE CIRCULATOR, S.S. FITTED, FLANGE CONNECTIONS, 26GPM @ 26' TDH, 0.35 HP, 120V/1PH/60HZ w/ 110°F AQUASTAT	GRUNDFOS	UPS26-150SF		-	1"	-	-
CP2	HOT WATER RECIRC PUMP	FIXT	CARTRIDGE CIRCULATOR, BRONZE/S.S. FITTED, FLANGE CONNECTIONS, 6 GPM @ '12 TDH, 0.078 HP, 120V/1PH/60HZ w/ 110°F AQUASTAT	GRUNDFOS	UPS15-55SFC		-	3/4"	-	-
HS1	WALL HUNG HAND SINK, ADA	BOWL	20x18 V.C. RIM 34" AFF MAX.	AMERICAN STANDARD	0355.0221	1,2,3,5	1/2"	1/2"	2"	2"
		FAUCET	4" CENTERSET, LEVER HANDLE, V.P.	DELTA	501					
		DRAIN	GRID STRAINER	DELTA						
		MIXING VALVE	LEAD FREE THERMOSTATIC MIXING VALVE - SETPOINT = 105°F INSTALL ON HOT WATER SUPPLY, ASSE 1070	CASH-ACME	HG-135					
HS2	1-COMPARTMENT COUNTERTOP SINK, ADA	BOWL	15x17x5.5, 18 GA S.S.	ELKAY	LRAD1517	2,3,4,5	1/2"	1/2"	2"	2"
		FAUCET	GOOSENECK,WRISTBLADE HANDLE, V.P. LAMINAR FLOW AERATOR	DELTA	26T3925					
		DRAIN	CRUMBCUP STRAINER	ELKAY	LK35					
		MIXING VALVE	LEAD FREE THERMOSTATIC MIXING VALVE - SETPOINT = 105°F INSTALL ON HOT WATER SUPPLY, ASSE 1070	CASH-ACME	HG-135					

NOTES
1. PROVIDE MATCHING WALL HANGER. COORDINATE WITH G.C. TO PROVIDE FRAMING AND BLOCKING TO PROPERLY SUPPORT FIXTURE.
2. PROVIDE BRASS 1-1/2" TAILPIECE, CAST BRASS SLIP JOINT P-TRAP WITH CLEANOUT; PROVIDE ADA OFFSET ARRANGEMENT AND/OR TRAP PRIMER CONNECTION WHERE REQUIRED.
3. PROVIDE ADA INSULATION KIT
4. COORDINATE WITH MILLWORK.
5. PROVIDE 1/2" IPS X 3/8" OD BRASS STOP(S) WITH RIGID COPPER RISERS. ALL EXPOSED PIPING SHALL BE CHROME PLATED.
6. PROVIDE TRAP PRIMER
7. PROVIDE ROUGH-IN COMPLETE w/ WALL OUTLET BOX, SIOUX CHIEF 696, SEE DRAWING DETAIL. COORDINATE WITH FURNISHED TUB INSTALLATION INSTRUCTIONS.
8. TRIP LEVER TO BE LOCATED ON WIDE SIDE OF TOILET ROOM.
9. PROVIDE INLINE CHECK VALVES FOR WATER SUPPLY LINES AND 1/2" DCW SUPPLY FOR OWNER FURNISHED CHEMICAL DISPENSER ADJACENT TO SINK.
10. COLOR SELECTED BY ARCHITECT.
11. PROVIDE ROUGH-IN COMPLETE, SEE DRAWING DETAIL. COORDINATE WITH FURNISHED EQUIPMENT INSTALLATION INSTRUCTIONS.
12. REFER TO ARCHITECTURAL DETAILS FOR VALVE/HEAD ARRANGEMENT.
13. REQUIRED AT SINK SK1 IN NURSE'S STATION #27, #38, #59.

KITCHEN EQUIPMENT SCHEDULE

MARK	FIXTURE	PIPE SIZES						NOTES
		CW	HW 110°F	HW 140°F	WASTE	VENT	GAS	
2	HAND SINK	1/2"	1/2"	-	2"	2"	-	SEE NOTE 8.
3	EYE WASH SINK BY P.C.	1/2"	1/2"	-	2"	2"	-	PROVIDE TEPID WATER THROUGH MIXING VALVE
12/13	VEG. PREP. TABLE W/ SINK	3/4"	-	3/4"	ID	-	-	
15	ICE MACHINE W/ BIN	1/2"	-	-	ID	-	-	PROVIDE BFP. SEE NOTE 3.
16	CONVECTION OVEN	-	-	-	-	-	3/4"	LOAD = 54 MBH
17	FRYERS W/ FILTERS	-	-	-	-	-	3/4"	LOAD = 90 MBH
19	2 COMP. STEAMER	1/2"		-	ID	-	3/4"	LOAD=125 MBH
25	6 BURNER RANGE WITH GRIDDLE	-		-	-	-	3/4"	LOAD = 286 MBH
26	TILT SKILLET	-	-	-	-	-	3/4"	LOAD =100 MBH
27	FLOOR TROUGH	-	-	-	-	-	3/4"	
34	HOT FOOD TABLE	-	-	-	ID	-	-	
36	WORK TABLE W/ SINK	3/4"	-	3/4"	ID	-	-	
37	COFFEE BREWER	1/2"	-	-	-	-	-	PROVIDE BFP. SEE NOTE 3.
42	TABLE W/ DRAIN BOARD	-	-	-	ID	-	-	
43	TEA BREWER	1/2"	-	-	-	-	-	
56	SOILED DISH TABLE	3/4"	-	3/4"	ID	-	-	SEE NOTE 4, 5.
58	PRE-RINSE SPRAY	-	-	3/4"	-	-	-	SEE NOTE 4.
59	FOOD WASTE GRINDER	1/2"	-	-	ID	-	-	SEE NOTE 3.
61/63	DISH WASHER W/ BOOSTER	-	-	3/4"	ID	-	-	SEE NOTE 5, 6
64	MIXING FAUCET	3/4"	-	3/4"	-	-	-	SEE NOTE 4.
65	PRE-RINSE SPRAY W/ ADD A FAUCET	3/4"	-	3/4"	-	-	-	SEE NOTE 4.
67	POT AND PAN SINK	3/4"	-	3/4"	ID	-	-	DOUBLE FAUCETS. SEE NOTE 4 AND 7.
69/70	MOP SINK / UTILITY FAUCET BY P.C.	3/4"	-	3/4"	3"	2"	-	FURNISHED BY P.C.

NOTES:
1. ID INDICATES INDIRECT DRAIN
2. PLUMBING CONTRACTOR TO ROUGH-IN AND MAKE FINAL PLUMBING CONNECTIONS TO ALL KITCHEN EQUIPMENT. COORDINATE w/ KITCHEN EQUIPMENT SUPPLIER.
3. DUAL CHECK NSF APPROVED FOR FOOD SERVICE, WATTS Cu7 OR EQUAL AS APPROVED BY LOCAL JURISDICTION .
4. PROVIDE CHECK VALVES ON HOT AND COLD WATER SUPPLIES.
5. PROVIDE SIZE 'A' WATER HAMMER ARRESTOR.
6. DRAIN TEMPERING VALVE - THERMO OMEGA TECH 1/2" DTV
7. INSTALL 1/2" DCW SUPPLY w/ RPZ & BALL VALVE FOR SANITIZER DISPENSER AND 1/2" DHW w/ RPZ & BALL VALVE FOR DETERGENT DISPENSER.
8. INSTALL 1/2" THERMOSTATIC MIXING VALVE - SETPOINT = 105°F INSTALL ON HOT WATER SUPPLY, ASSE 1070, CASH-ACME HG-135.

NOURISHMENT STATION EQUIPMENT SCHEDULE

MARK	FIXTURE	PIPE SIZES					NOTES
		CW	HW 110°F	HW 140°F	WASTE	VENT	
3	HOT FOOD TABLE	-	-	-	ID	-	1,2
6	WORK TABLE W/ SINK	3/4"	-	3/4"	ID	-	1,2,3
8	ICE MACHINE/STORAGE BIN	1/2"	-	-	ID	-	1,2,3,4

NOTES:
1. ID INDICATES INDIRECT DRAIN
2. PLUMBING CONTRACTOR TO ROUGH-IN AND MAKE FINAL PLUMBING CONNECTIONS TO ALL KITCHEN EQUIPMENT. COORDINATE w/ KITCHEN EQUIPMENT SUPPLIER.
3. PROVIDE SIZE 'A' WATER HAMMER ARRESTOR
4. DUAL CHECK NSF APPROVED FOR FOOD SERVICE, WATTS Cu7 OR EQUAL AS APPROVED BY LOCAL JURISDICTION .

GREASE INTERCEPTOR SIZING- KITCHEN

FIXTURE TYPE	QUAN	PIPE DIAMETER	GPM/FIXTURE	FIXTURE RATING	GPM
2 or 3 comp pot sink	1	1 1/2	15	1.00	15
1 or 2 comp meat prep sink	1	1 1/2	15	0.75	11.25
1 or 2 comp vegetable prep sink	1	1 1/2	15	0.25	3.75
Pre-rinse sink	1	1 1/2	15	0.50	7.5
Wok/tilt kettle	1	3	5	1.00	5
Dishwasher					10
Disposer					6
Can wash/mop sink					12
Total					**64.5**
Grease Interceptor Size = flow rate x 24 minutes =					**1548**
Round up to the next available size to deteremine the required grease interceptor:					2000 gal

GREASE INTERCEPTOR SIZING- NOURISHMENT STATION

FIXTURE TYPE	QUAN	PIPE DIAMETER	GPM/FIXTURE	FIXTURE RATING	GPM
1 comp sink	1	1 1/2	15	0.75	11.25
Total					**11.25**
Grease Interceptor Size = flow rate x 24 minutes =					**270**
Round up to the next available size to deteremine the required grease interceptor:					430 gal

PLUMBING NOTES

1. MAIN WATER LINES ARE SHOWN ON OVERALL PLAN DRAWINGS. SEE TYPICAL AND ENLARGED PLANS FOR BRANCH PIPING NOT SHOWN ON OVERALL PLANS.
2. ROUTE WATER LINES IN ATTIC TO AVOID CATWALKS. WHERE PIPING CROSSES CATWALK, ROUTE OVERHEAD (6' MIN. ABOVE CATWALK) OR UNDER CATWALK FLOOR. COORDINATE CONNECTIONS TO HVAC EQUIPMENT WITH MECHANICAL CONTRACTOR.
3. MINIMUM WATER LINE SIZE SHALL BE 1/2". MINIMUM VENT SIZE SHALL BE 2". MINIMUM WASTE SIZE SHALL BE 2".
4. ALL PIPING PENETRATIONS THRU SMOKE AND FIRE WALLS SHALL BE SEALED PER APPROPRIATE LISTED ASSEMBLIES. SEE ARCHITECTURAL DRAWINGS FOR DETAILS.
5. PIPE ROUTING IS APPROXIMATE BASED ON ASSUMED FRAMING ARRANGEMENTS, ADJUST ROUTING AS REQUIRED TO CONFORM TO STRUCTURE.
6. ICE MAKERS SHALL DRAIN THRU 2" AIR GAP INTO FLOOR DRAIN. PROVIDE REMOVABLE NO. 10 MESH SCREEN OVER PIPE DISCHARGE OPENING AND CUT VERTICAL DROP AT 45° ANGLE
7. DO NOT INSTALL VTR'S ON FRONT FACING ROOF. EXTEND ALL VENTS TO EXIT BACK SIDE OF ROOF LINE. INDIVIDUAL VENTS AND VTR'S INDICATED ON DRAWINGS MAY BE COMBINED INTO A SINGLE VTR PROVIDED CODE SIZING AND ARRANGEMENT IS FOLLOWED.
8. RECESS ALL SHOWERS FLUSH WITH FLOOR FOR HANDICAPPED ACCESSIBILITY.
9. VERIFY AND COORDINATE PLUMBING CONNECTIONS WITH SITE UTILITY PLANS.
10. MAINTAIN 25'-0" MINIMUM BETWEEN ALL PLUMBING VENTS AND MECHANICAL INTAKES.
11. PROVIDE SHUTOFFS ON WATER SUPPLIES TO EACH GROUP OF FIXTURES AS INDICATED OR REQUIRED BY CODE.

PLUMBING ABBREVIATIONS

(X)	EXISTING
A.F.F.	ABOVE FINISHED FLOOR
A.R.C.I.	ACID RESISTANT CAST IRON
ADA	AMERICANS WITH DISABILITIES ACT
BRZ.	BRONZE
BT	BATHTUB
C.I.	CAST IRON
CO	CLEANOUT
CONC.	CONCRETE
DCW	DOMESTIC COLD WATER
DHW	DOMESTIC HOT WATER
DIA.	DIAMETER
E.C.I.	ENAMELED CAST IRON
EC	ELECTRICAL CONTRACTOR
EWC	ELECTRIC WATER COOLER
EWH	ELECTRIC WATER HEATER
FCO	FLOOR CLEANOUT
FD	FLOOR DRAIN
FS	FLOOR SINK
GA.	GAUGE
GAL.	GALLON
GC	GENERAL CONTRACTOR
GCO	GRADE CLEANOUT
GPF	GALLONS PER FLUSH
GPH	GALLONS PER HOUR
GPM	GALLONS PER MINUTE
GWH	GAS-FIRED WATER HEATER
HB	HOSE BIBB
INCL.	INCLUDED
KS	KITCHEN SINK
LAV	LAVATORY
LP	LIQUID PROPANE
MS	MOP SERVICE BASIN
NAT.	NATURAL GAS
NKL.	NICKEL
NON SIMULT.	NON SIMULTANEOUS
O.F.L.C.	OPEN FRONT LESS COVER
OB	OUTLET BOX
OC	ON CENTER
ORDL	OVERFLOW ROOF DRAIN LEADER
PC	PLUMBING CONTRACTOR
PRESS. BAL.	PRESSURE BALANCED
RCVY.	RECOVERY
RDL	ROOF DRAIN LEADER
SH	SHOWER
SK	SINK
SLD.	SLIDE
SS	STAINLESS STEEL
TDH	TOTAL DYNAMIC HEAD
TP	TRAP PRIMER
UR	URINAL
V	VENT
VB	VACUUM BREAKER
VC	VITREOUS CHINA
VR	VANDAL RESISTANT
VTR	VENT THROUGH ROOF
W	WASTE
WC	WATER CLOSET
WCO	WALL CLEANOUT
WH	WALL HYDRANT

NOTE: ALL ABBREVIATIONS MAY NOT BE USED IN PROJECT.

GAS WATER HEATER SCHEDULE

DRAWING CODE	DESCRIPTION	LOCATION	DESIGN BASIS MFR	MODEL	CAPACITY (GPM @°F RISE)	FUEL			WATER CONN.	ELECTRICAL	NOTES
						TYPE	INPUT (MBH)	GAS CONNECTION		VOLTAGE (V/PH/HZ)	
GWH1A	TANKLESS, FREE STANDING RACK SYSTEM	MECH. 49	RINNAI	TRS04CXiN	30.8 @ 50	NG	(4) 199	1-1/2"	2"	120/1/60	1-5
GWH1B	TANKLESS, FREE STANDING RACK SYSTEM	MECH. 49	RINNAI	TRS04CXiN	30.8 @ 50	NG	(4) 199	1-1/2"	2"	120/1/60	
GWH2A	TANKLESS, FREE STANDING RACK SYSTEM	MECH. 49	RINNAI	TRS04CXiN	19.2 @ 80	NG	(4) 199	1-1/2"	2"	120/1/60	
GWH2B	TANKLESS, FREE STANDING RACK SYSTEM	MECH. 49	RINNAI	TRS04CXiN	19.2 @ 80	NG	(4) 199	1-1/2"	2"	120/1/60	

NOTES:
1 EACH RACK SYSTEM INCLUDES (4) CU199i 199 MBH INPUT CONDENSING TANKLESS WATER HEATERS WITH PRE-PIPED COLD WATER, HOT WATER, GAS AND DRAIN MANIFOLDS AND FLOOR SUPPORT FRAME.
2 PRE- WIRED ELECTRICAL ASSEMBLY WITH (2) 20A 125V 2-POLE 3-WIRE GROUNDING RECEPTACLES (EACH RACK).
3 COORDINATE ELECTRICAL REQUIREMENTS WITH ELECTRICAL CONTRACTOR.
4 MSB-M MODULAR ELECTRONIC CONTROL SYSTEM WITH INTERCONNECTING WIRING TO STAGE ALL HEATERS IN EACH GWH AS A GROUP.
5 11.3 GALLON ACCEPTANCE EXPANSION TANK @ 100PSI MAX, 60 PSI INLET, NSF RATED FOR POTABLE WATER,AMTROL ST-30VC-DD

GAS LOAD SCHEDULE

FIXTURE TAG	DESCRIPTION	BTUH RATING	QUANTITY	TOTAL
GWH1A/B	TANKLESS WATER HEATER RACK	796,000	2	1,592,000
GWH2A/B	TANKLESS WATER HEATER RACK	796,000	2	1,592,000
DOAS	DEDICATED OUTDOOR AIR UNIT	419,563	1	419,563
16	GAS CONVECTION OVEN	54,000	1	114,000
17	GAS FRYER	90,000	1	90,000
19	STEAMER	125,000	1	125,000
25	60" GAS RANGE	286,000	1	286,000
26	TILT SKILLET	63,000	1	63,000
-	75LB DRYER	225,000	3	675,000
TOTAL LOAD				4,956,563
BUILDING GAS PRESSURE				2 psi

PLUMBING LOADS

WASTE (DRAINAGE FIXTURE UNITS)	639.5
WATER	130 GPM

WALL TYPE LEGEND

1 HOUR FIRE BARRIER WALL
1 HOUR FIRE/SMOKE BARRIER WALL
SMOKE RESISTANT WALL
2 HOUR FIRE BARRIER WALL

PIPING LEGEND

	DOMESTIC COLD WATER PIPING
DWCS	DOMESTIC CHILLED WATER SUPPLY PIPING
DWCR	DOMESTIC CHILLED WATER RETURN PIPING
	SANITARY WASTE PIPING
	SANITARY VENT PIPING
D	DRAIN PIPING
140°F	DOMESTIC 140°F WATER PIPING
140°R	DOMESTIC 140°R WATER PIPING
NG	NATURAL GAS PIPING

CBHF Engineers, PLLC
2246 Yaupon Drive Phone: 910.791.4000
Wilmington, NC 28401 Fax: 910.791.5266
www.cbhfengineers.com
© Copyright 2026 CBHF Engineers, PLLC NC# P-0506

NORTH CAROLINA PROFESSIONAL ENGINEER SEAL 10592 JAMES R. POLSTON
09/25/2026

09-29-2026 BID


PRUITTHEALTH
FORSYTH COUNTY, L.L.C.
Winston–Salem, North Carolina

David R. Polston - Architect
3806 Pork Ave. Suite 2–L, Wilmington, NC 28403
Architecture Planning Design


100 BED FACILITY
PLUMBING SCHEDULES, NOTES, ABBREVIATIONS

P0.1


Drawing: N:\Polston\2008\Pruitt-Winston-Salem\2008 RX.dwg Plot Time: 9/25/2026 11:01 AM

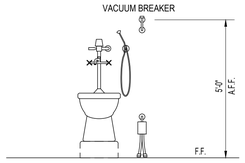


1 CLINICAL SINK DETAIL
NOT TO SCALE

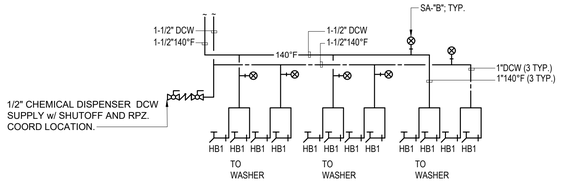


2 COMMERCIAL WASHER DETAIL
NOT TO SCALE

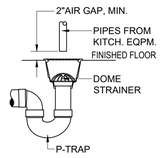


3 FLOOR SINK DETAIL
NOT TO SCALE

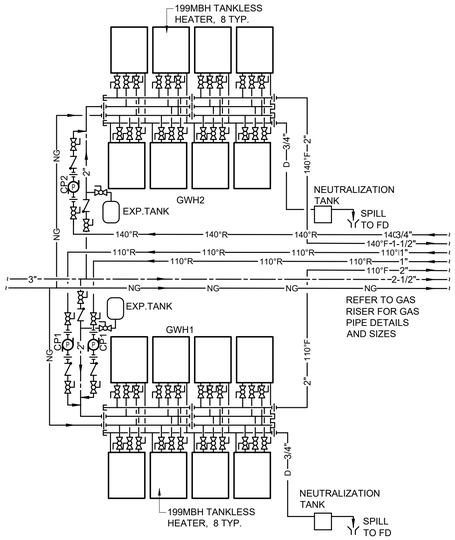


5 GAS WATER HEATER DETAIL
NOT TO SCALE

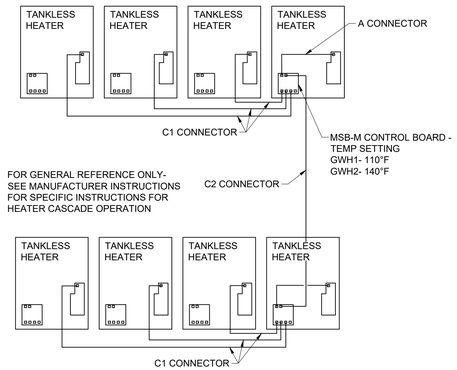

6 GAS WATER HEATER CONTROL DETAIL
NOT TO SCALE

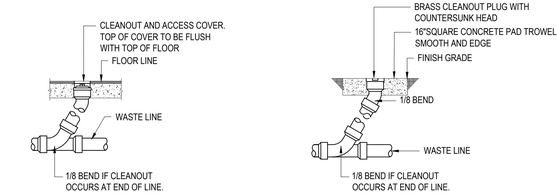


FLOOR CLEANOUT (FCO) — GRADE CLEANOUT (GCO)

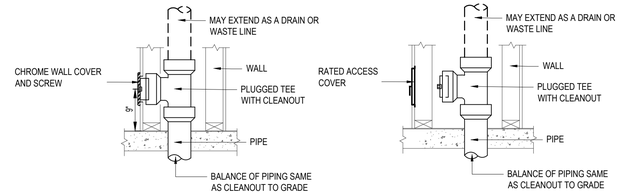

NOTE: CLEANOUT TO BE FLUSH WITH FINISHED WALL.


WALL CLEANOUT (WCO) — WALL CLEANOUT (WCO) RATED WALL

4 CLEANOUT DETAILS
NOT TO SCALE

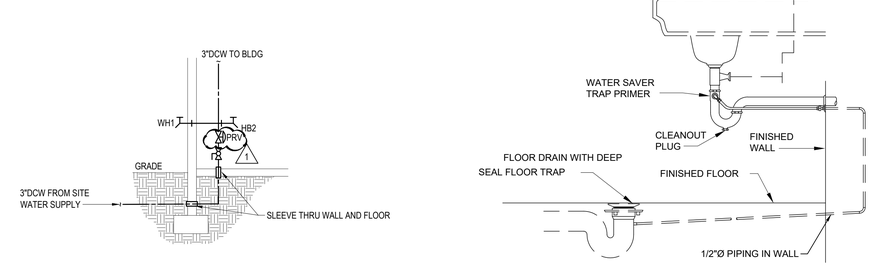

7 WATER SERVICE ENTRANCE DETAIL
NOT TO SCALE


12 TAILPIECE TRAP PRIMER DETAIL
NOT TO SCALE

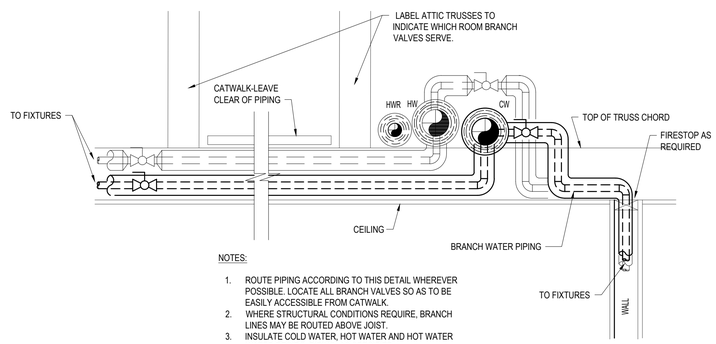


NOTES:

1. ROUTE PIPING ACCORDING TO THIS DETAIL WHEREVER POSSIBLE. LOCATE ALL BRANCH VALVES SO AS TO BE EASILY ACCESSIBLE FROM CATWALK.
2. WHERE STRUCTURAL CONDITIONS REQUIRE, BRANCH LINES MAY BE ROUTED ABOVE JOIST.
3. INSULATE COLD WATER, HOT WATER AND HOT WATER WATER RECIRC. PIPING AS SPECIFIED.
4. COORDINATE WITH MECHANICAL AND ELECTRICAL EQUIPMENT.

8 ATTIC WATER PINING DETAIL
NOT TO SCALE

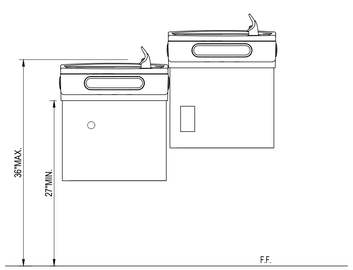


10 BI-LEVEL WATER COOLER DETAIL
NOT TO SCALE

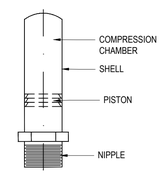

ALWAYS INSTALL IN UPRIGHT POSITION

JOSAM NO.	P.D.I. SYMBOL	FIXTURE UNIT RATING	PIPE SIZE
7501-S	A	1-11	1/2
7502-S	B	12-32	3/4
7503-S	C	33-60	1
7504-S	D	61-113	1 1/4
7505-S	E	114-154	1 1/2
7506-S	F	155-330	2

10 HAMMER ARRESTOR SCHEDULE AND DETAIL
NOT TO SCALE

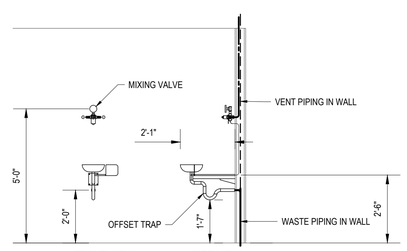

11 WALL MOUNTED EYEWASH DETAIL
NOT TO SCALE

CBHF Engineers, PLLC
2246 Yaupon Drive Phone: 910.791.4000
Wilmington, NC 28401 Fax: 910.791.5266
www.cbhfengineers.com
NC# P-0506
© Copyright 2026 CBHF Engineers, PLLC

NORTH CAROLINA PROFESSIONAL ENGINEER SEAL 10592 JAMES R. PENSON

09/25/2026

09-29-2026 BID

PRUITTHEALTH
FORSYTH COUNTY, L.L.C.
Winston-Salem, North Carolina

David R. Polston - Architect
3806 Park Ave. Suite 2-L, Wilmington, NC 28403
Architecture Planning Design


REV	DESCR.	DATE
1	REVISIONS PER PLAN REVIEW	09.29.2026

100 BED FACILITY


PLUMBING DETAILS

P0.2


Drawing: N:\Polston\2200\8-Pruitt Winston-Salem\2208 PR.dwg Plot Time: 9/25/2026 11:01 AM

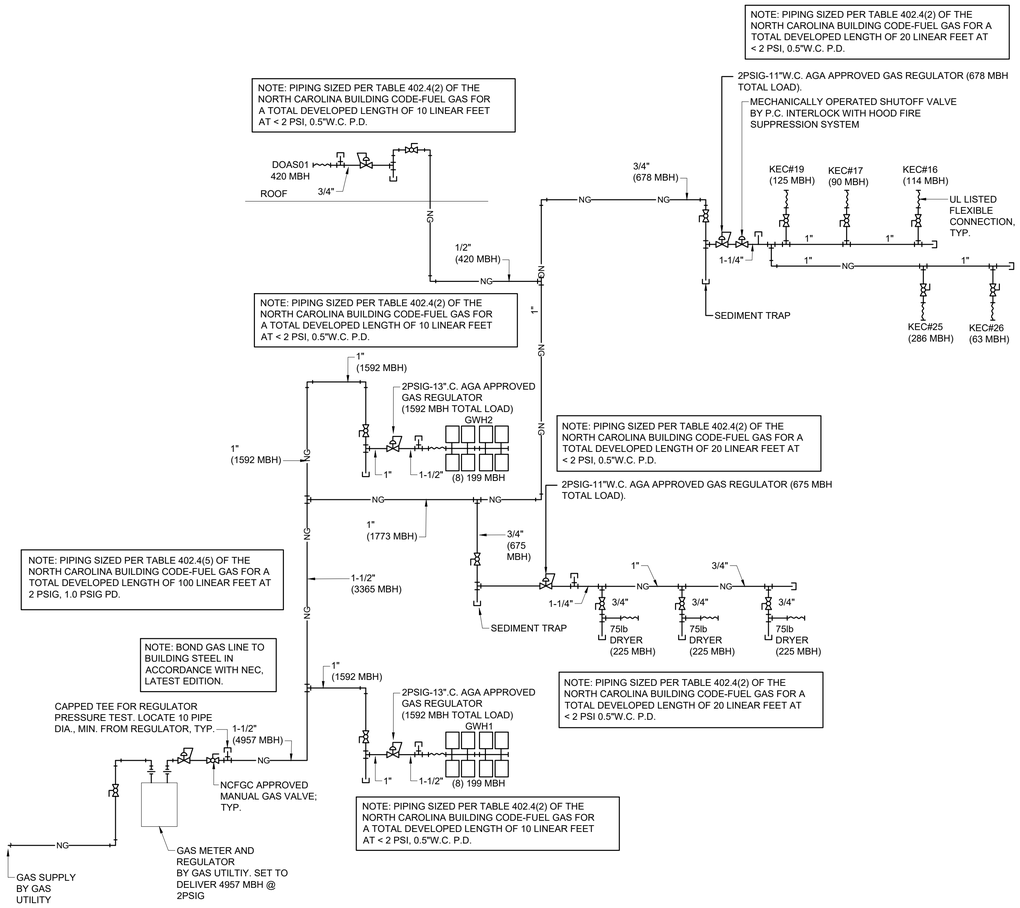

1 GAS RISER DIAGRAM
NOT TO SCALE

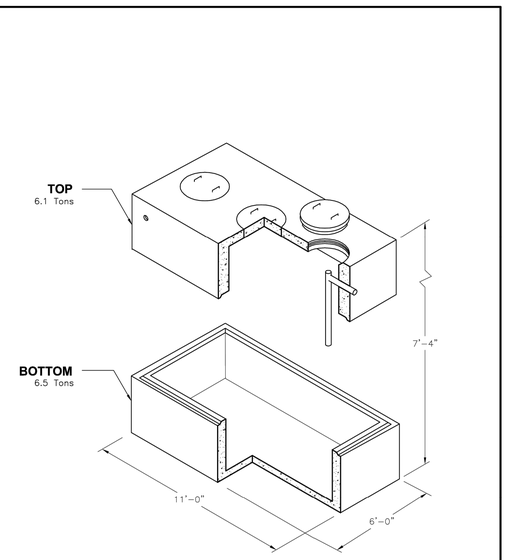


Oldcastle Precast®	GT-2000	5'-0" x 10'-0" x 6'-4" I.D. Grease Trap 2,000 Gallon Capacity
	FILE NAME: 324ECGGT2000_ISO.DWG	
	ISSUE DATE: January, 2008	
	www.oldcastleprecast.com	Copyright ©2008 Oldcastle Precast®

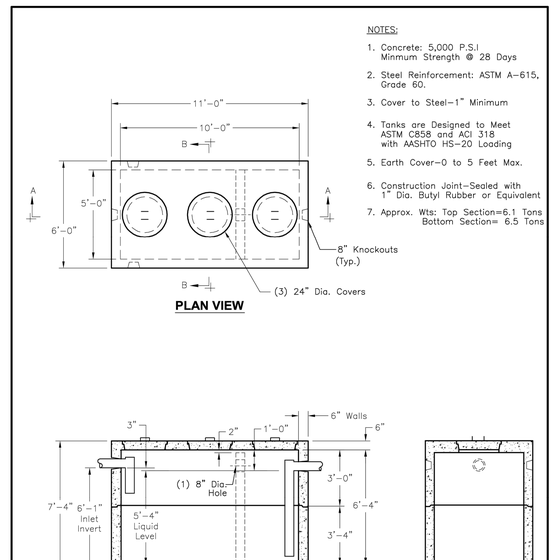


Oldcastle Precast®	GT-2000	5'-0" x 10'-0" x 6'-4" I.D. Grease Trap 2,000 Gallon Capacity
	FILE NAME: 324ECGGT2000_DET.DWG	
	ISSUE DATE: January, 2008	
	www.oldcastleprecast.com	Copyright ©2008 Oldcastle Precast®


7 GREASE INTERCEPTOR DETAILS
NOT TO SCALE

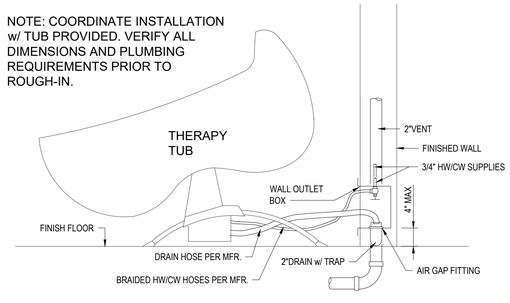


2 THERAPY TUB DETAIL
NOT TO SCALE

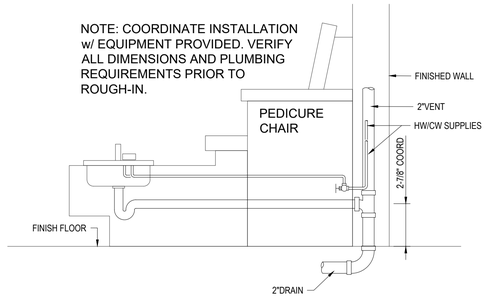

3 PEDICURE CHAIR DETAIL
NOT TO SCALE

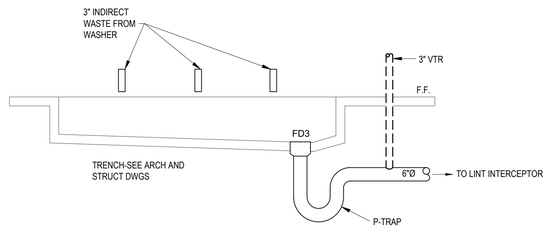

5 WASHER DRAIN DETAIL
NOT TO SCALE

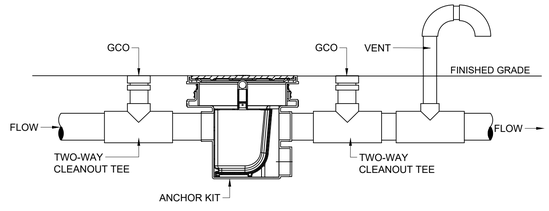

6 LINT INTERCEPTOR DETAIL
NOT TO SCALE

CBHF Engineers, PLLC
2246 Yaupon Drive Phone: 910.791.4000
Wilmington, NC 28401 Fax: 910.791.5266
www.cbhfengineers.com
NC# P-0506
© Copyright 2026 CBHF Engineers, PLLC

NORTH CAROLINA PROFESSIONAL ENGINEER SEAL 10592 JAMES R. BENSON
09/25/2026

09-29-2026 BID

PRUITTHEALTH
FORSYTH COUNTY, L.L.C.
Winston-Salem, North Carolina

David R. Polston - Architect
3806 Park Ave. Suite 2-L, Wilmington, NC 28403
Architecture Planning Design

100 BED FACILITY
PLUMBING DETAILS


P0.3

CBHF
Engineers, PLLC
2246 Yaupon Drive Phone: 910.791.4000
Wilmington, NC 28401 Fax: 910.791.5266
www.cbhfengineers.com
NC# P-0506
© Copyright 2026 CBHF Engineers, PLLC


NORTH CAROLINA PROFESSIONAL SEAL 10592 ENGINEER JAMES R. POLSTON

09/25/2026


09-29-2026 BID

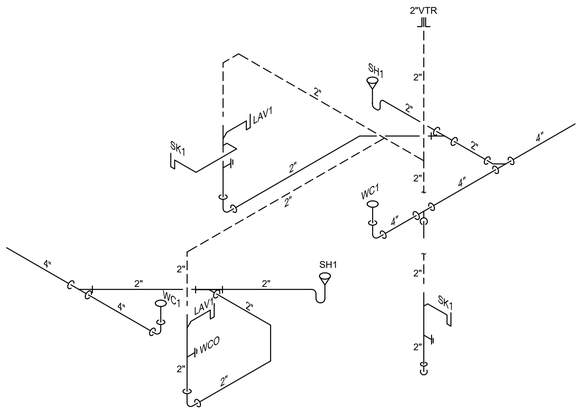


1 WASTE-VENT RISER DIAGRAM TYPICAL PRIVATE BEDROOM (SUITE)
NOT TO SCALE

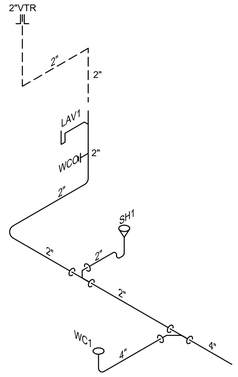


2 WASTE-VENT RISER DIAGRAM TYPICAL PRIVATE BEDROOM
NOT TO SCALE

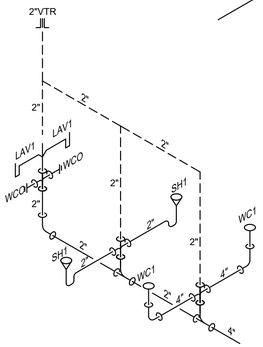


3 WASTE-VENT RISER DIAGRAM TYPICAL BACK-TO-BACK PRIVATE BEDROOM
NOT TO SCALE

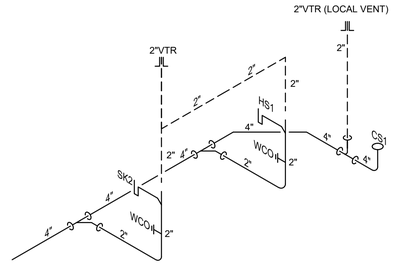


4 WASTE-VENT RISER DIAGRAM TYPICAL S.U /S.L.
NOT TO SCALE

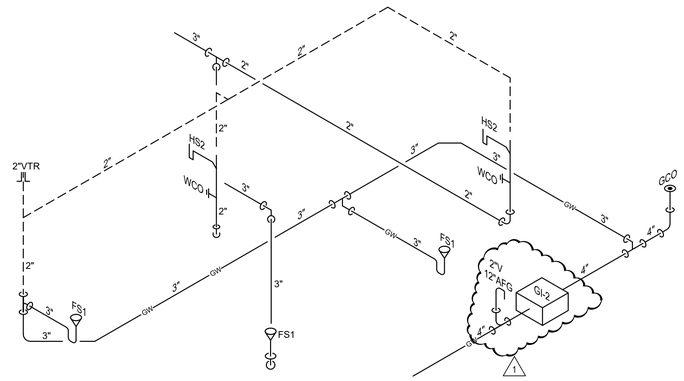


5 WASTE-VENT RISER DIAGRAM TYPICAL NOURISHMENT STATION
NOT TO SCALE

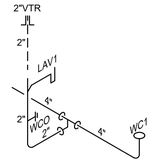


6 WASTE-VENT RISER DIAGRAM TYPICAL STAFF LOUNGE
NOT TO SCALE

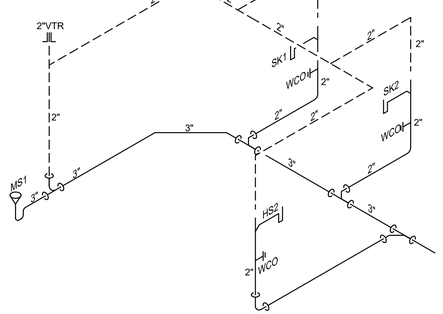

7 WASTE-VENT RISER DIAGRAM TYPICAL NUR. STA/MED PREP/JAN.
NOT TO SCALE

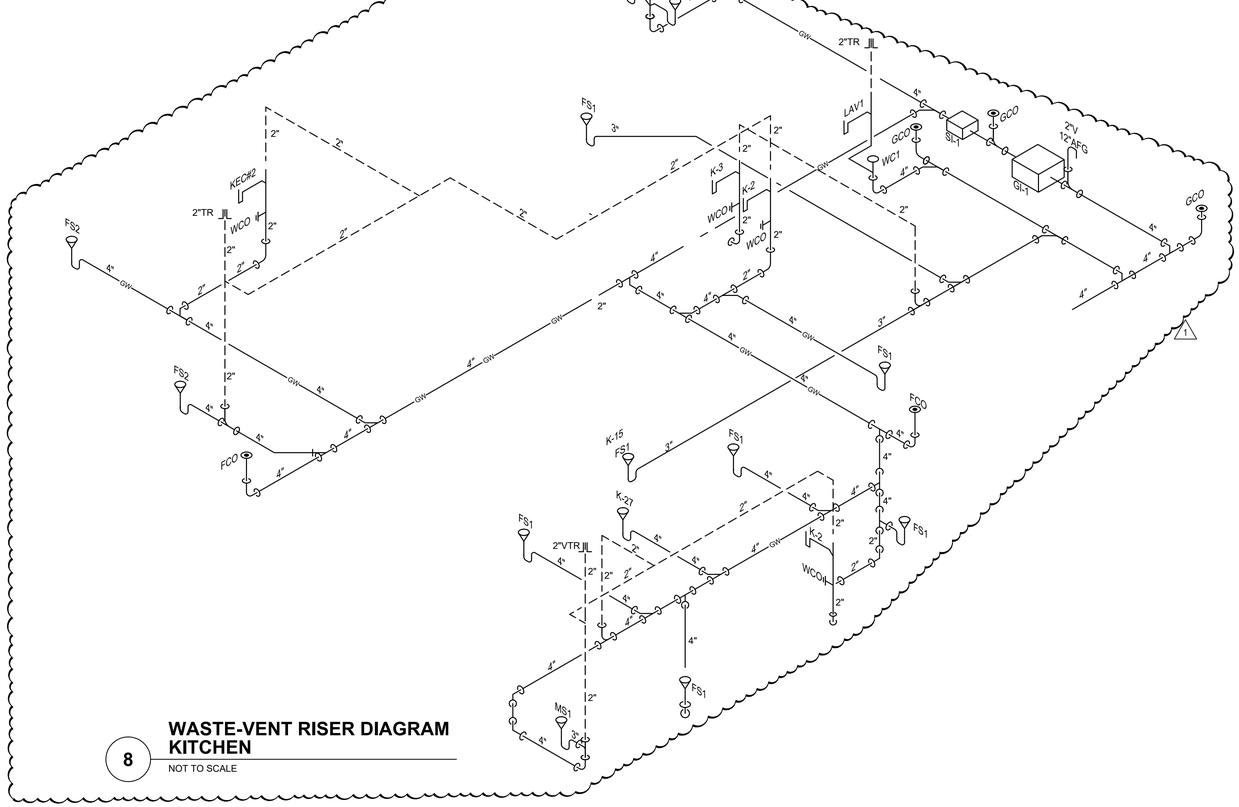

8 WASTE-VENT RISER DIAGRAM KITCHEN
NOT TO SCALE

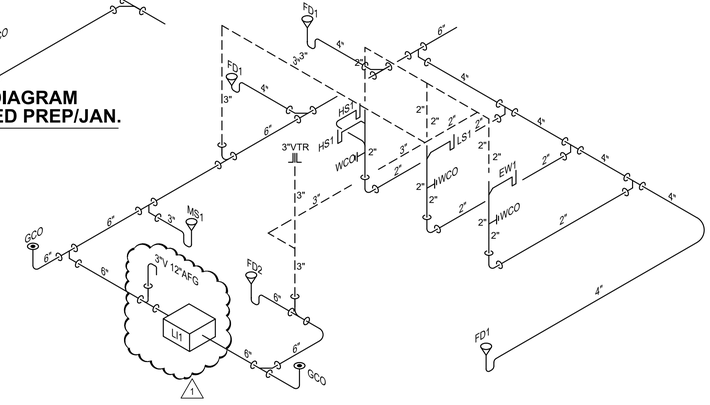

9 WASTE-VENT RISER DIAGRAM LAUNDRY
NOT TO SCALE

David R. Polston - Architect
3806 Park Ave. Suite 2–L, Wilmington, NC 28403
Architecture Planning Design


PRUITTHEALTH
FORSYTH COUNTY, L.L.C.
Winston–Salem, North Carolina

REV	DESCR	DATE
1	REVISIONS PER PLAN REVIEW	09.29.2026

100 BED FACILITY


RISER DIAGRAMS

P0.4

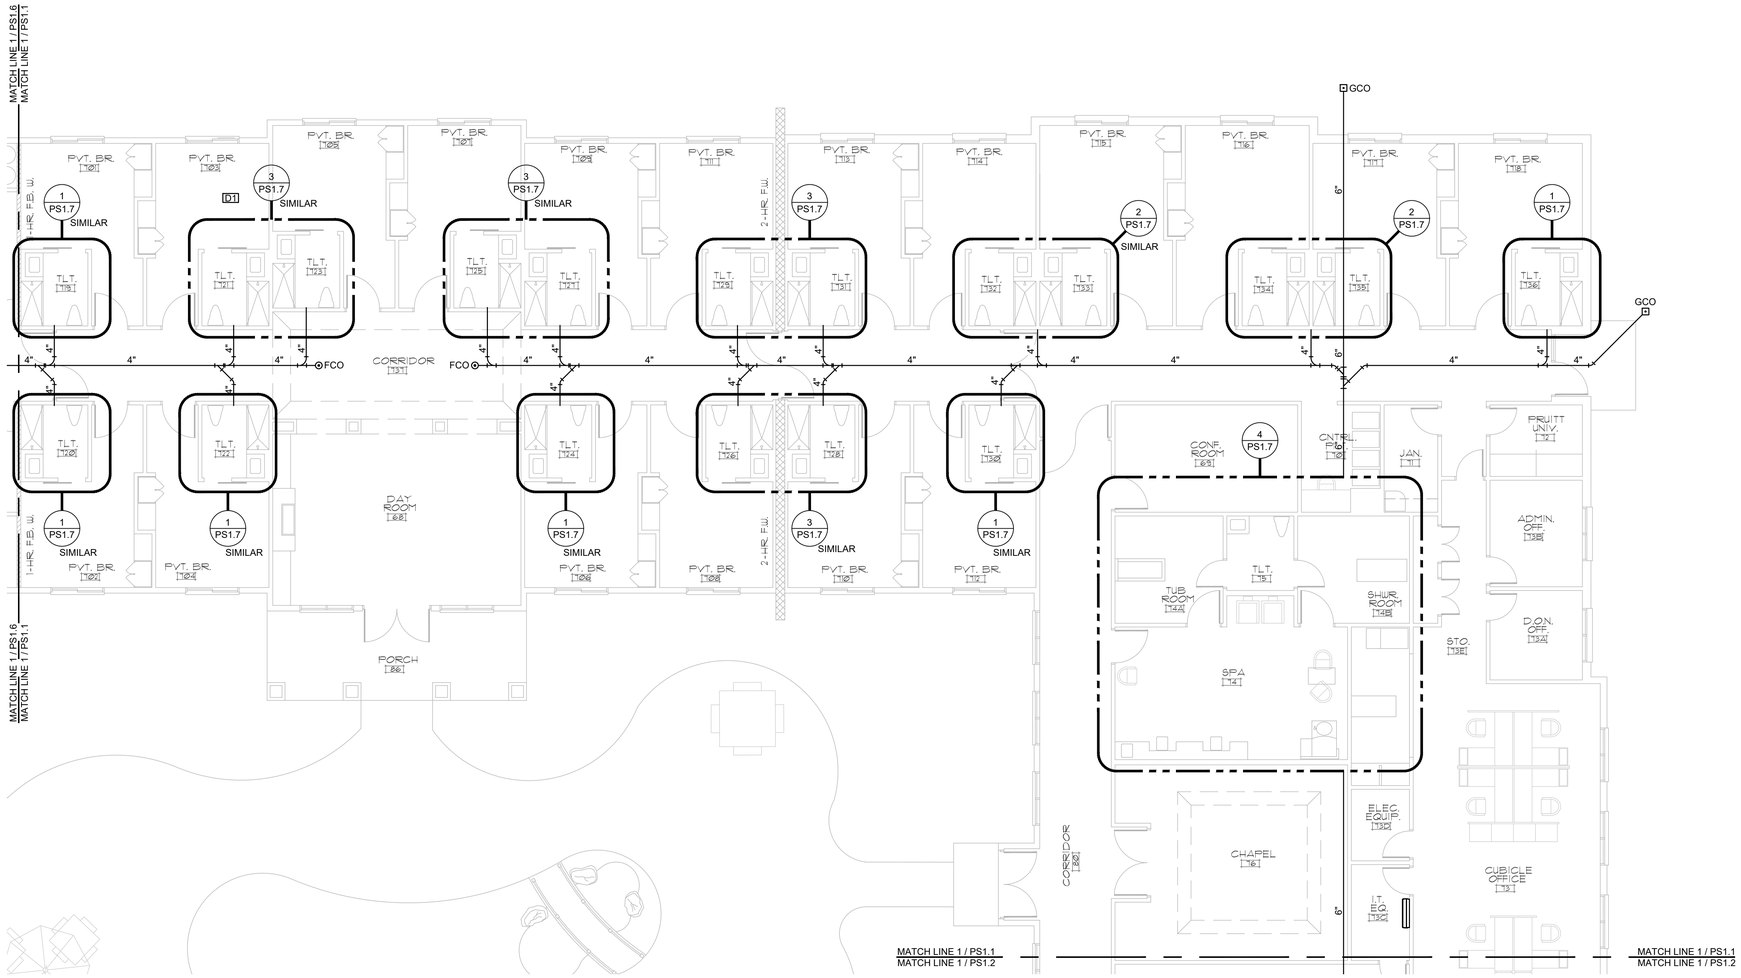

1 **PARTIAL WASTE-VENT PLAN**
1/8" = 1'-0"
0 4' 8' 16'

PLAN NORTH

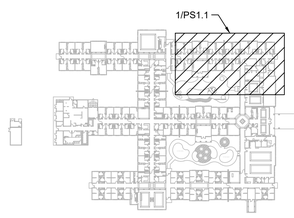

0 **KEYPLAN**
NOT TO SCALE

CBHF
Engineers, PLLC
2246 Yaupon Drive Phone: 910.791.4000
Wilmington, NC 28401 Fax: 910.791.5266
www.cbhfengineers.com
NC# P-0506
© Copyright 2026 CBHF Engineers, PLLC

NORTH CAROLINA PROFESSIONAL SEAL 10592 ENGINEER JAMES R. POLSTON

09/25/2026


09-29-2026 BID

PRUITTHEALTH
FORSYTH COUNTY, L.L.C.
Winston-Salem, North Carolina

David R. Polston - Architect
3806 Park Ave. Suite 2-L, Wilmington, NC 28403
Architecture Planning Design


100 BED FACILITY
PLUMBING PARTIAL WASTE-VENT PLAN

PS 1.1

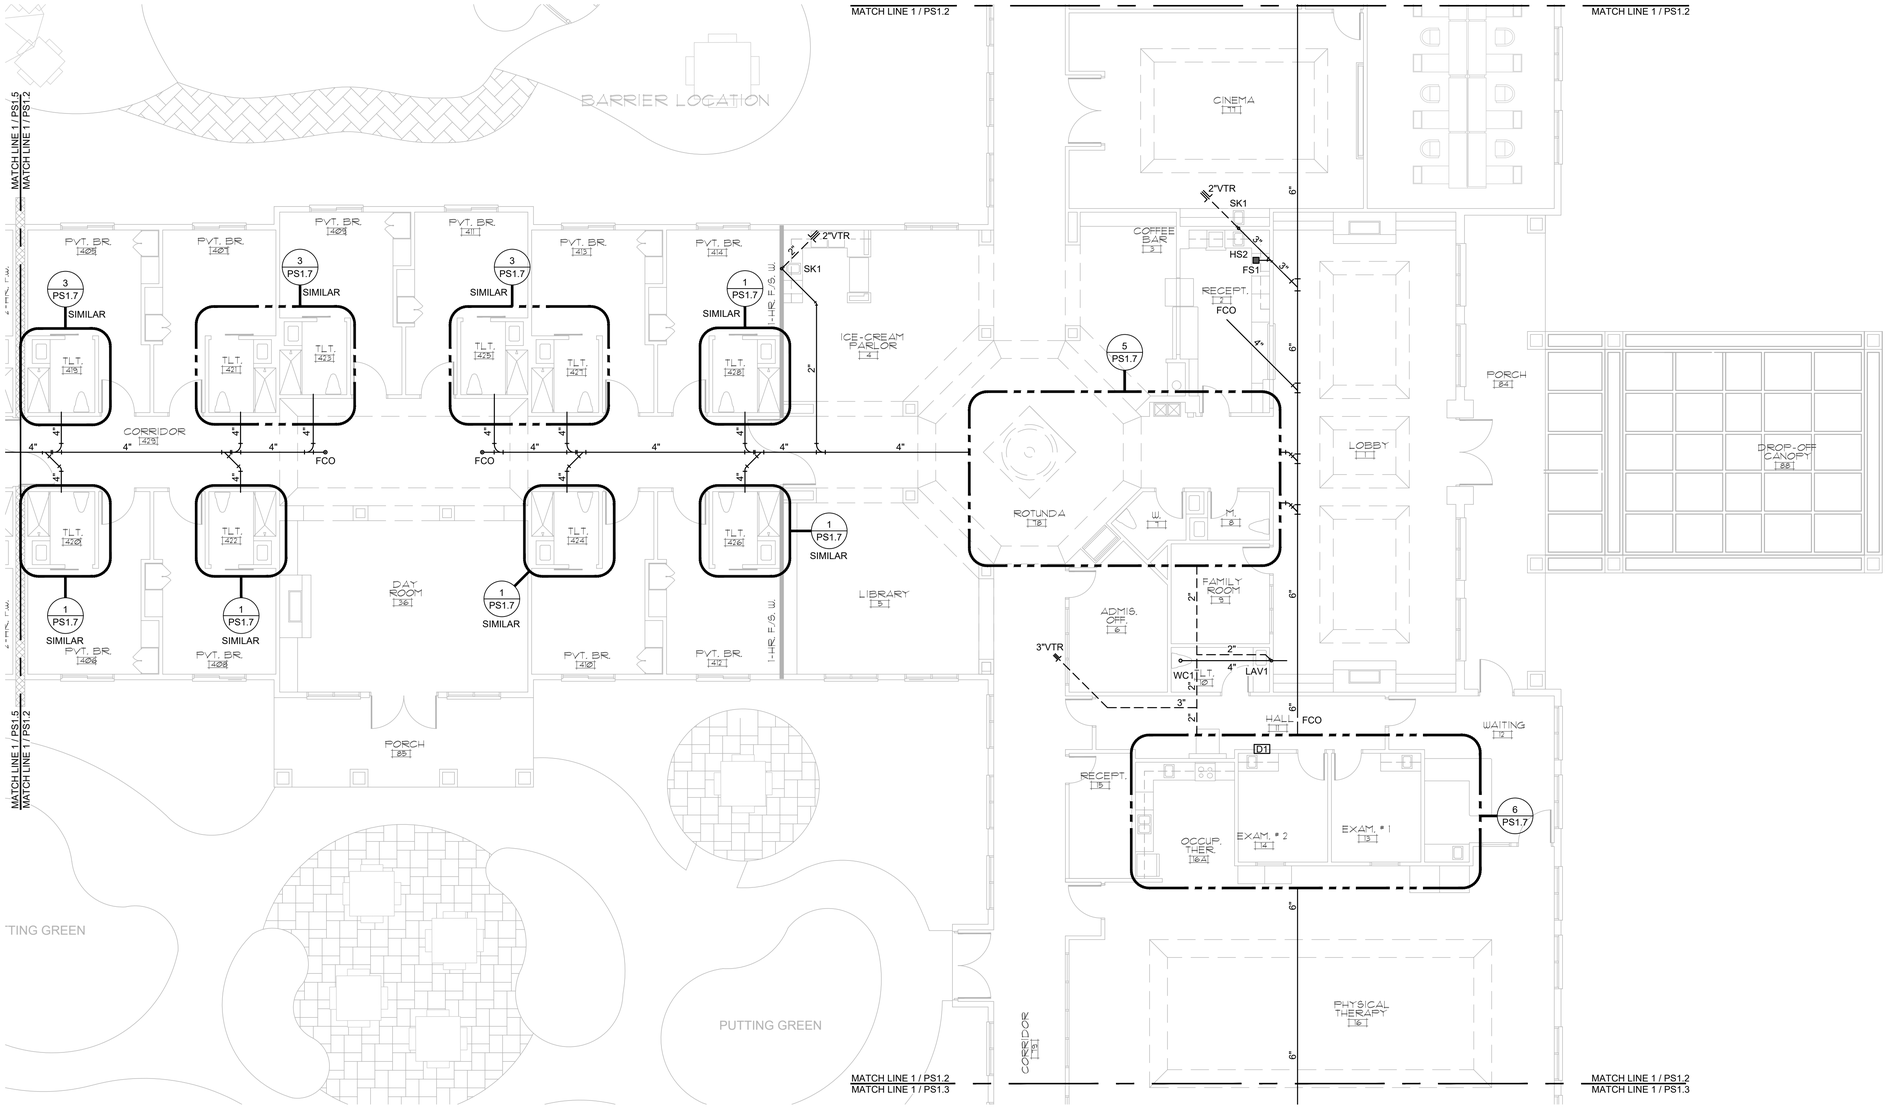

1 **PARTIAL WASTE-VENT PLAN**
1/8" = 1'-0"
0 4' 8' 16'

PLAN NORTH

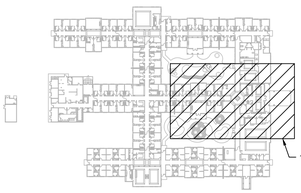

0 **KEYPLAN**
NOT TO SCALE

CBHF
Engineers, PLLC
2246 Yaupon Drive Phone: 910.791.4000
Wilmington, NC 28401 Fax: 910.791.5266
www.cbhfengineers.com
NC# P-0506
© Copyright 2026 CBHF Engineers, PLLC

NORTH CAROLINA PROFESSIONAL ENGINEER SEAL 10592 JAMES R. PENSON
09/25/2026

09-29-2026 BID

PRUITTHEALTH
FORSYTH COUNTY, L.L.C.
Winston-Salem, North Carolina

David R. Polston - Architect
3806 Park Ave. Suite 2-L, Wilmington, NC 28403
Architecture Planning Design


100 BED FACILITY
PLUMBING PARTIAL
WASTE-VENT PLAN

PS 1.2


CBHF
Engineers, PLLC
2246 Yaupon Drive Phone: 910.791.4000
Wilmington, NC 28401 Fax: 910.791.5266
www.cbhfengineers.com
NC# P-0506
© Copyright 2026 CBHF Engineers, PLLC

NORTH CAROLINA PROFESSIONAL SEAL 10592 ENGINEER JAMES R. PENSON
09/25/2026

09-29-2026 BID

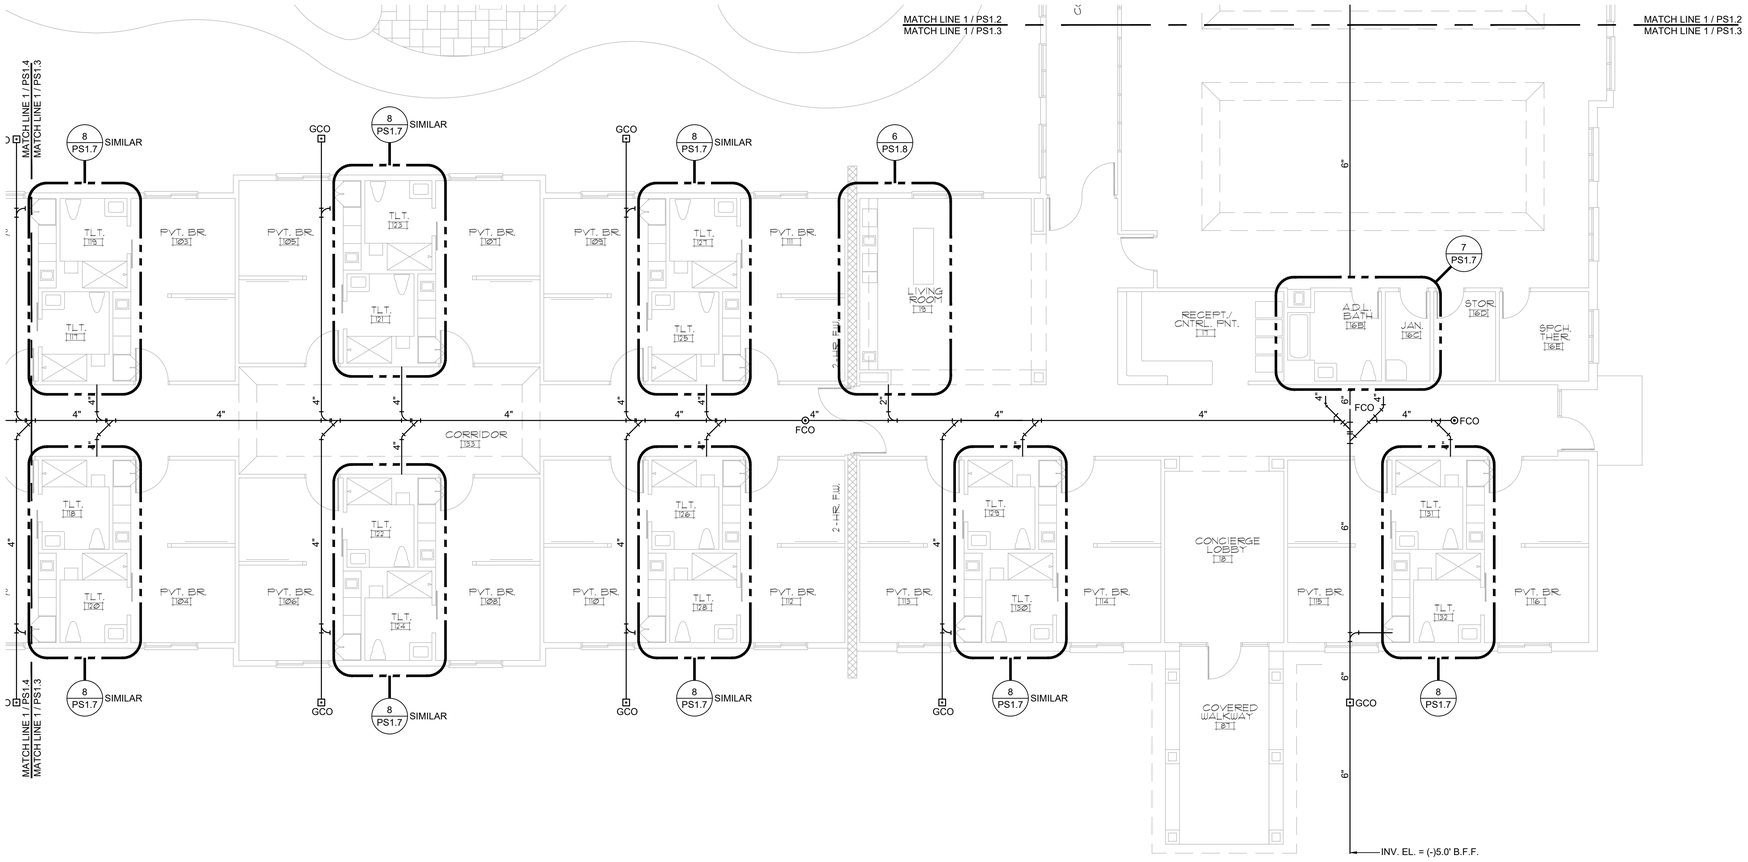

1 **PARTIAL WASTE-VENT PLAN**
1/8" = 1'-0"
0 4' 8' 16'
PLAN NORTH

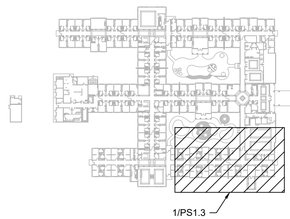

0 **KEYPLAN**
NOT TO SCALE

David R. Polston - Architect
3806 Park Ave. Suite 2-L, Wilmington, NC 28403
Architecture Planning Design

PRUITTHEALTH
FORSYTH COUNTY, L.L.C.
Winston-Salem, North Carolina

100 BED FACILITY
PLUMBING PARTIAL WASTE-VENT PLAN


PS 1.3

CBHF
Engineers, PLLC
2246 Yaupon Drive Phone: 910.791.4000
Wilmington, NC 28401 Fax: 910.791.5266
www.cbhfengineers.com
NC# P-0506
© Copyright 2026 CBHF Engineers, PLLC

NORTH CAROLINA PROFESSIONAL SEAL 10592 ENGINEER JAMES R. POLSTON

09/25/2026


09-29-2026 BID

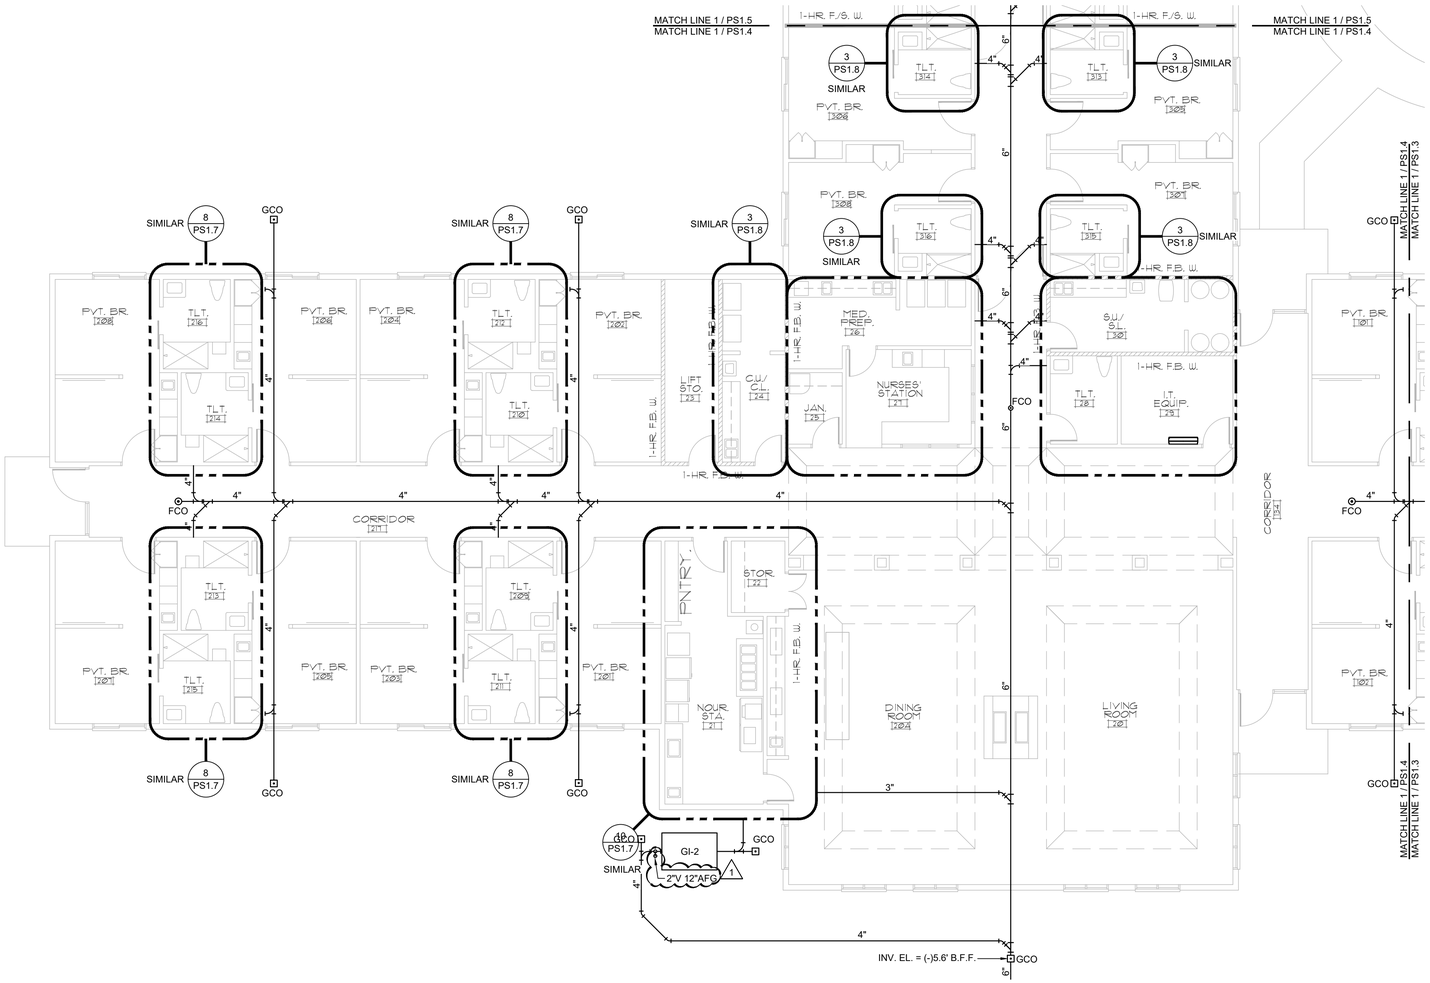

1 PARTIAL WASTE-VENT PLAN

1/8" = 1'-0"

PLAN NORTH

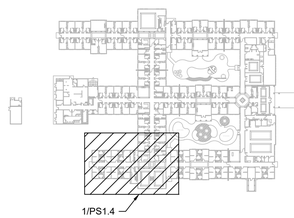

0 KEYPLAN
NOT TO SCALE

David R. Polston - Architect
3806 Park Ave. Suite 2-L, Wilmington, NC 28403
Architecture Planning Design

PRUITTHEALTH
FORSYTH COUNTY, L.L.C.
Winston-Salem, North Carolina

100 BED FACILITY
PLUMBING PARTIAL WASTE-VENT PLAN

PS 1.4


CBHF
Engineers, PLLC
2246 Yaupon Drive Phone: 910.791.4000
Wilmington, NC 28401 Fax: 910.791.5266
www.cbhfengineers.com
NC# P-0506
© Copyright 2026 CBHF Engineers, PLLC

NORTH CAROLINA PROFESSIONAL SEAL 10592 ENGINEER JAMES R. POLSTON
09/25/2026

09-29-2026 BID


PRUITTHEALTH
FORSYTH COUNTY, L.L.C.
Winston–Salem, North Carolina

David R. Polston - Architect
3806 Park Ave. Suite 2–L, Wilmington, NC 28403
Architecture Planning Design

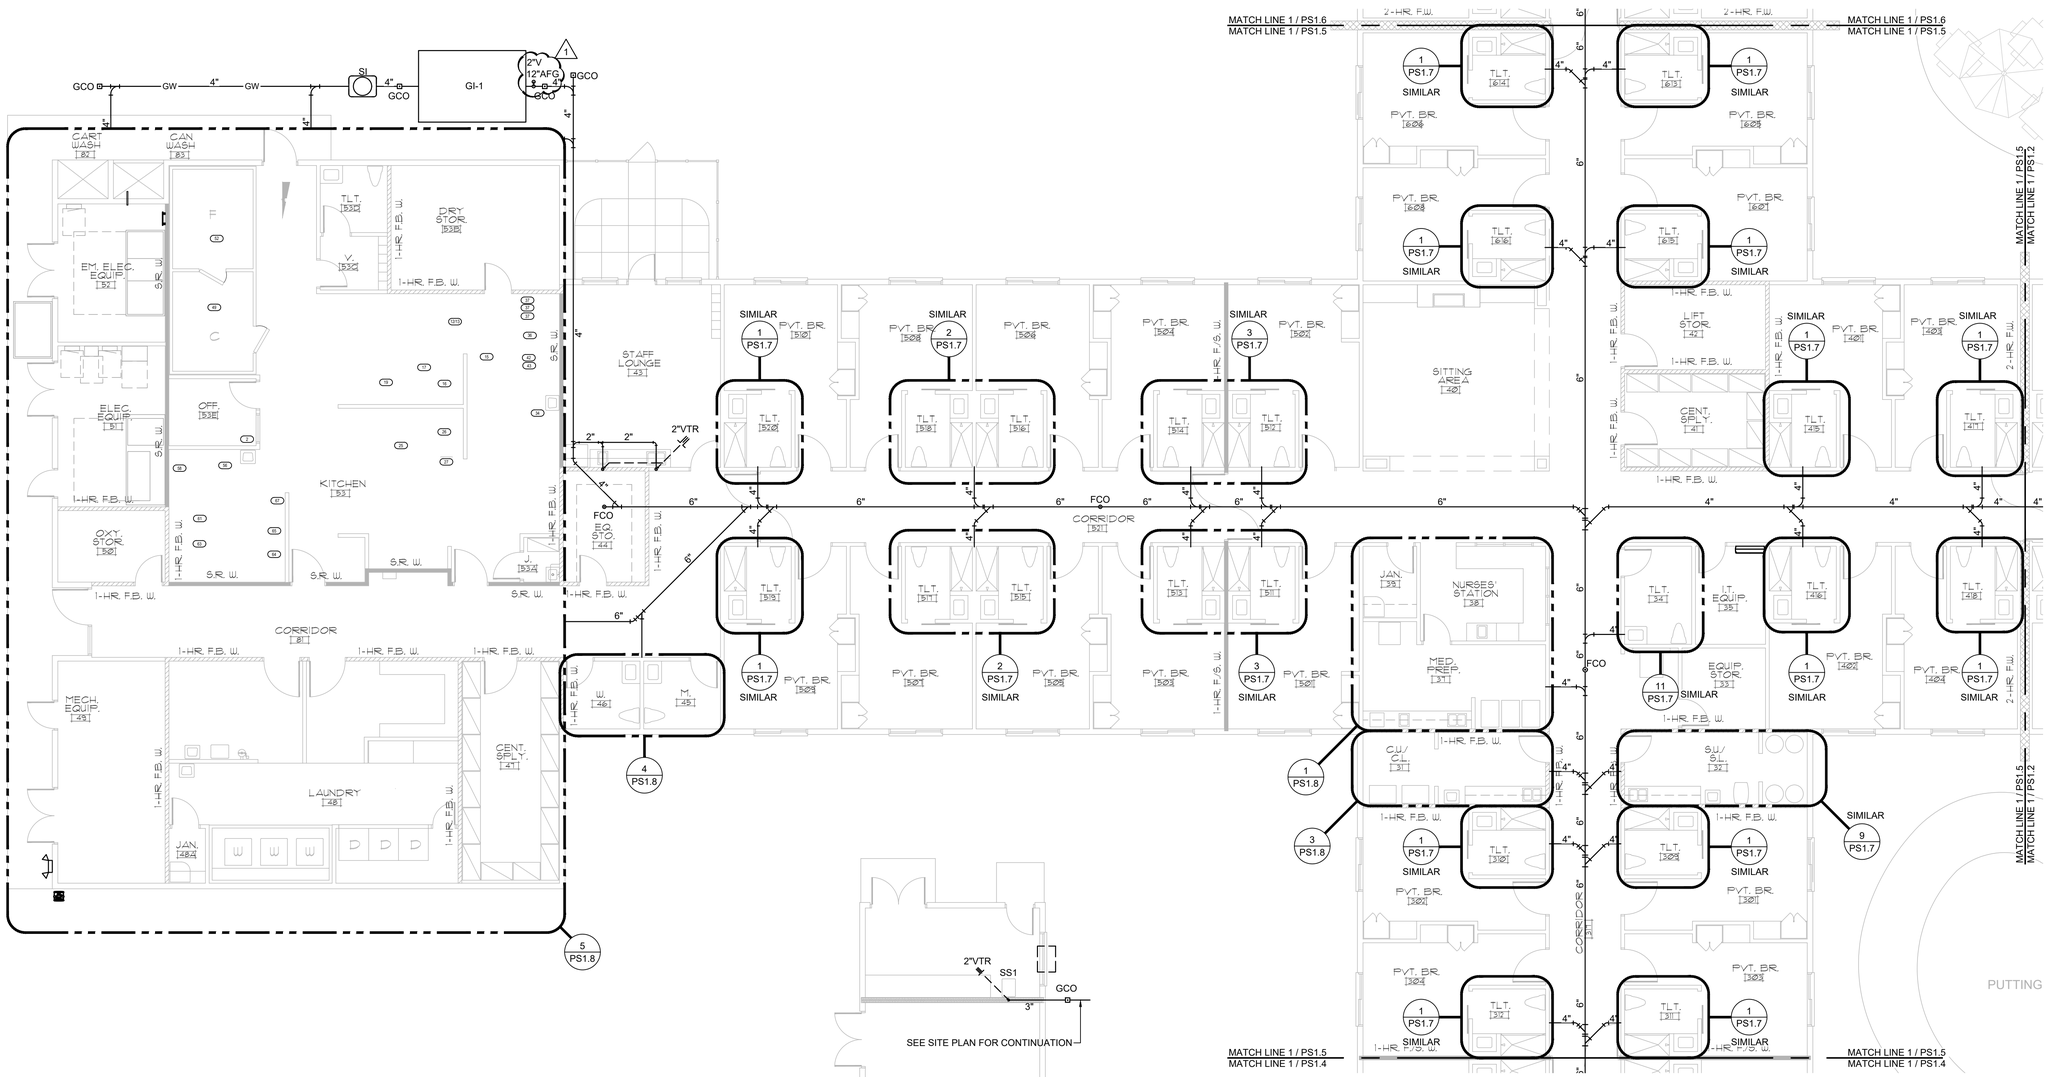

1 PARTIAL WASTE-VENT PLAN
1/8" = 1'-0"
PLAN NORTH

2 MAINTENANCE BLDG. WASTE-VENT PLAN
1/8" = 1'-0"
PLAN NORTH

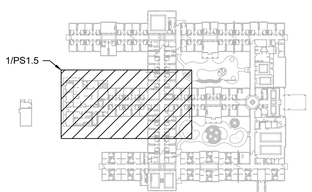

0 KEYPLAN
NOT TO SCALE

REV	DESCR	DATE
1	REVISIONS PER PLAN REVIEW	09.29.2026


100 BED FACILITY
PLUMBING PARTIAL WASTE-VENT PLAN

PS 1.5


CBHF
Engineers, PLLC
2246 Yaupon Drive Phone: 910.791.4000
Wilmington, NC 28401 Fax: 910.791.5266
www.cbhfengineers.com
NC# P-0506
© Copyright 2026 CBHF Engineers, PLLC

NORTH CAROLINA PROFESSIONAL ENGINEER SEAL 10592 JAMES R. BENSON, III
09/25/2026

09-29-2026 BID

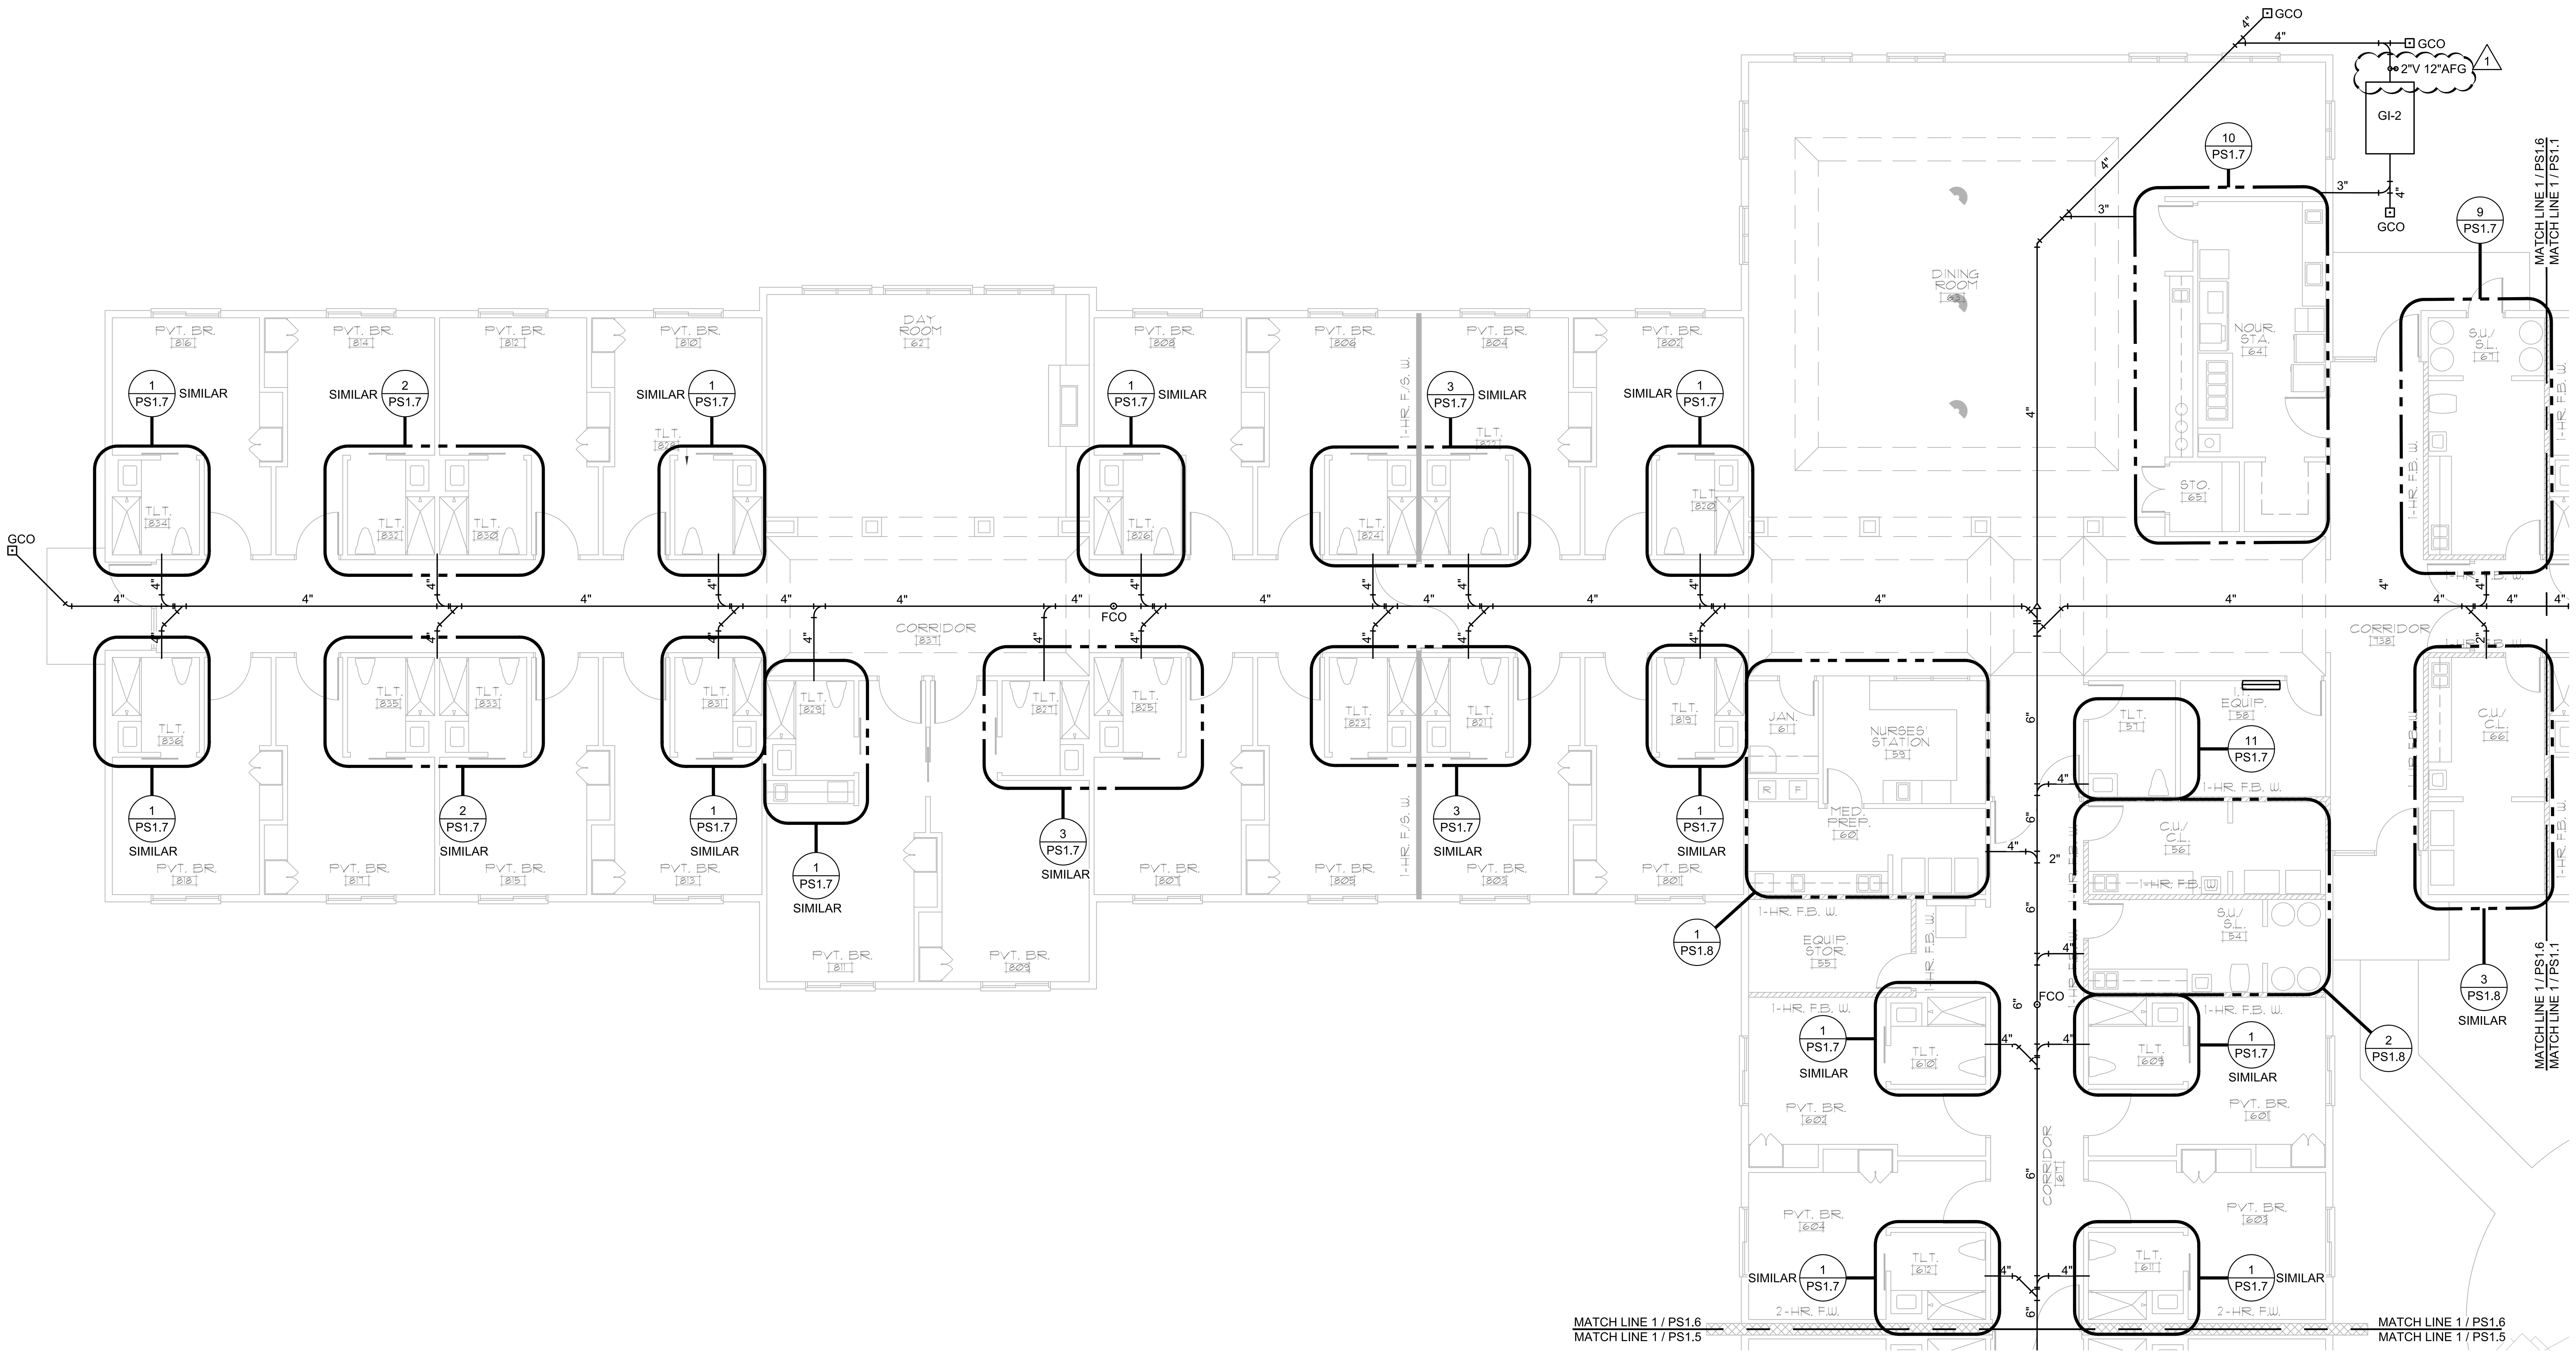

1 **PARTIAL WASTE-VENT PLAN**
1/8" = 1'-0"
0 4' 8' 16'
PLAN NORTH

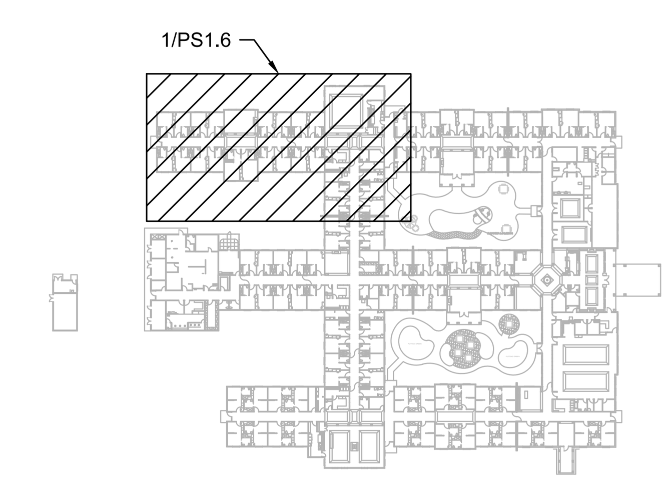

0 **KEYPLAN**
NOT TO SCALE

PRUITTHEALTH FORSYTH COUNTY, L.L.C.
Winston-Salem, North Carolina

David R. Polston - Architect
3806 Park Ave. Suite 2-L, Wilmington, NC 28403
Architecture Planning Design

REV	DESCR.	DATE
1	REVISIONS PER PLAN REVIEW	09.29.2026


100 BED FACILITY
PLUMBING PARTIAL WASTE-VENT PLAN

PS 1.6


CBHF
Engineers, PLLC
2246 Yaupon Drive Phone: 910.791.4000
Wilmington, NC 28401 Fax: 910.791.5266
www.cbhfengineers.com
NC# P-0506
© Copyright 2026 CBHF Engineers, PLLC

NORTH CAROLINA PROFESSIONAL SEAL 10592 ENGINEER JAMES R. POLSTON
09/25/2026


09-29-2026 BID

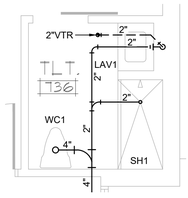


1 PARTIAL WASTE-VENT PLAN
1/4" = 1'-0"
PLAN NORTH

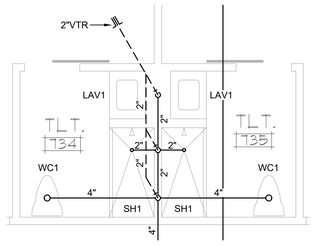


2 PARTIAL WASTE-VENT PLAN
1/4" = 1'-0"
PLAN NORTH

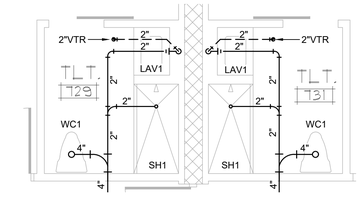


3 PARTIAL WASTE-VENT PLAN
1/4" = 1'-0"
PLAN NORTH

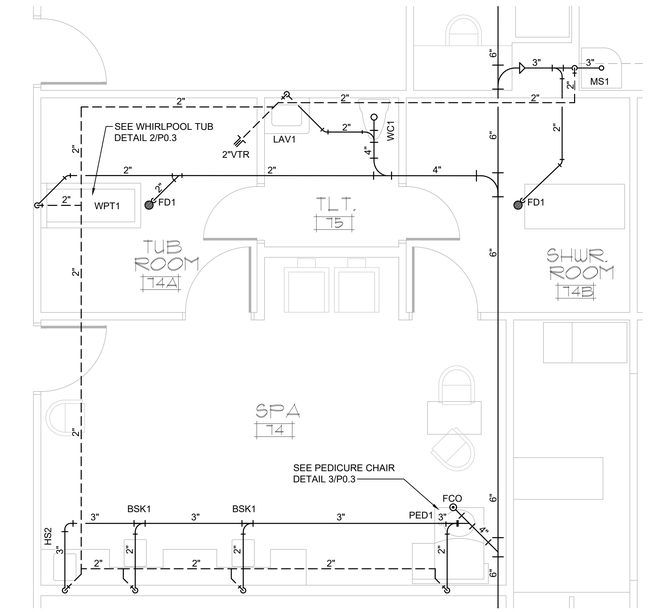


4 PARTIAL WASTE-VENT PLAN
1/4" = 1'-0"
PLAN NORTH

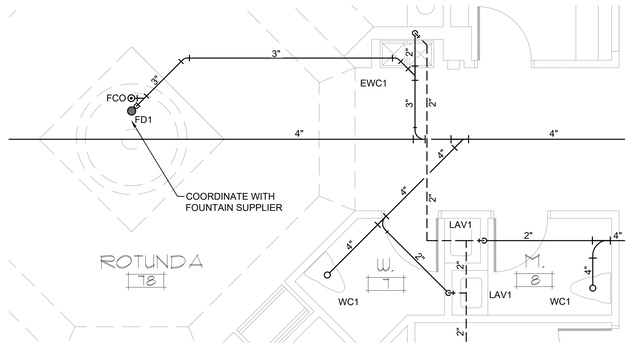


5 PARTIAL WASTE-VENT PLAN
1/4" = 1'-0"
PLAN NORTH

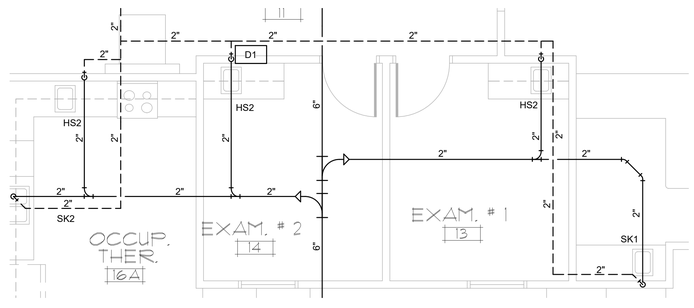


6 PARTIAL WASTE-VENT PLAN
1/4" = 1'-0"
PLAN NORTH

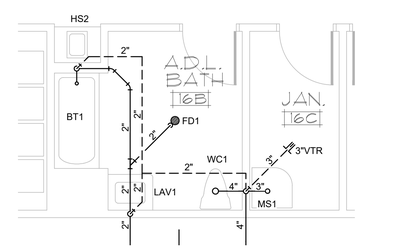


7 PARTIAL WASTE-VENT PLAN
1/4" = 1'-0"
PLAN NORTH

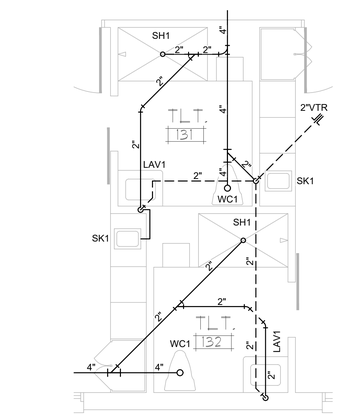


8 PARTIAL WASTE-VENT PLAN
1/4" = 1'-0"
PLAN NORTH

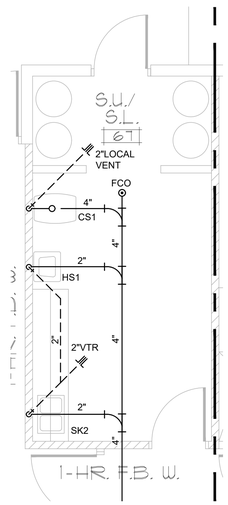

9 PARTIAL WASTE-VENT PLAN
1/4" = 1'-0"
PLAN NORTH

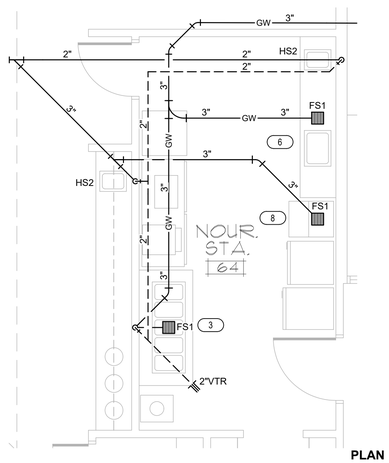

10 PARTIAL WASTE-VENT PLAN
1/4" = 1'-0"
PLAN NORTH

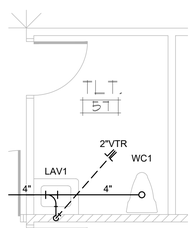


11 PARTIAL WASTE-VENT PLAN
1/4" = 1'-0"
PLAN NORTH

David R. Polston - Architect
3806 Park Ave. Suite 2-L, Wilmington, NC 28403
Architecture Planning Design

100 BED FACILITY
PLUMBING ENLARGED WASTE-VENT PLANS


PRUITTHEALTH
FORSYTH COUNTY, L.L.C.
Winston-Salem, North Carolina

PS
1.7

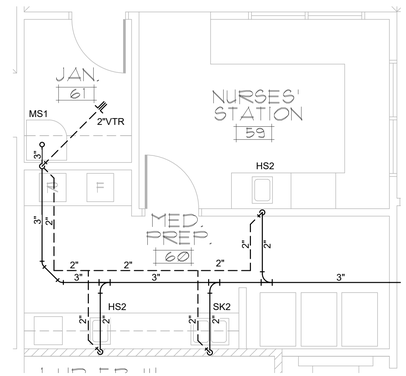


1 **PARTIAL WASTE-VENT PLAN**
1/4" = 1'-0"

PLAN NORTH

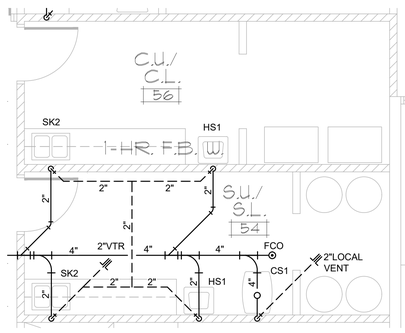


2 **PARTIAL WASTE-VENT PLAN**
1/4" = 1'-0"

PLAN NORTH

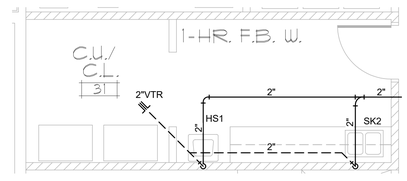


3 **PARTIAL WASTE-VENT PLAN**
1/4" = 1'-0"

PLAN NORTH

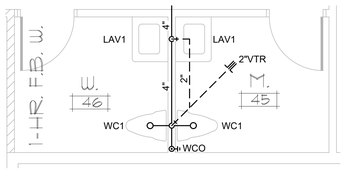


4 **PARTIAL WASTE-VENT PLAN**
1/4" = 1'-0"

PLAN NORTH

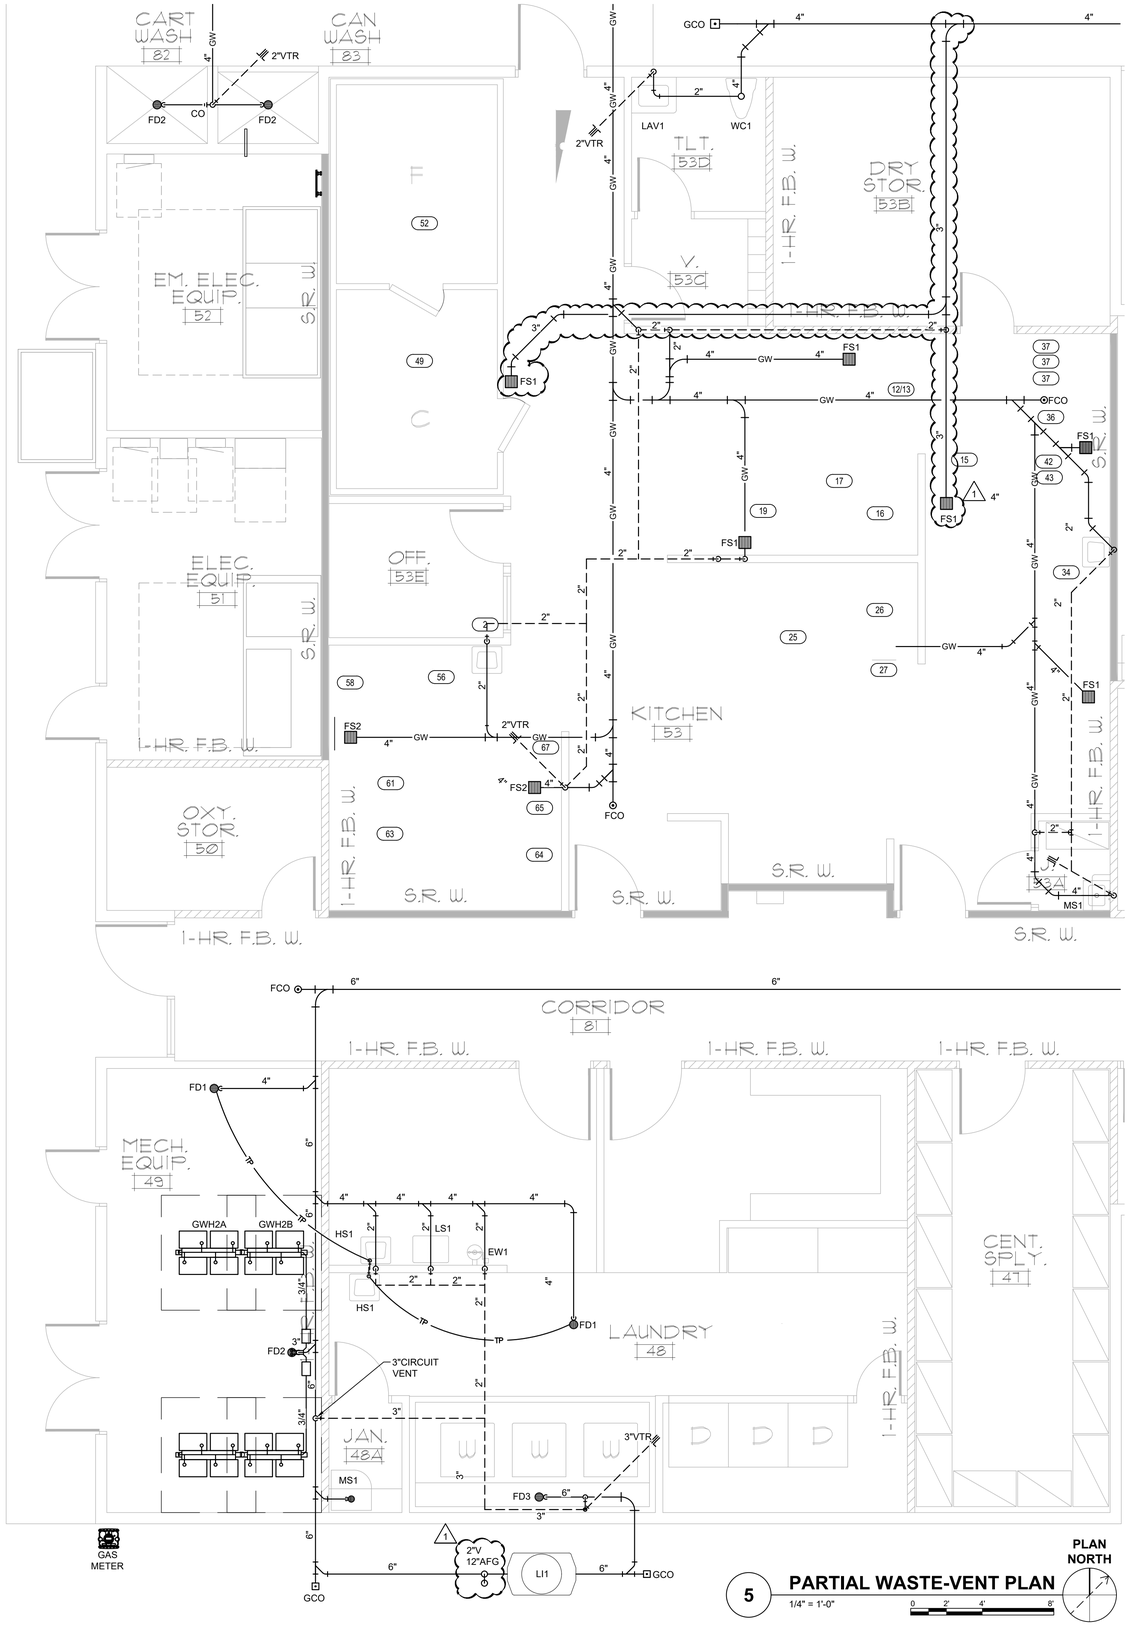

5 **PARTIAL WASTE-VENT PLAN**
1/4" = 1'-0"

PLAN NORTH

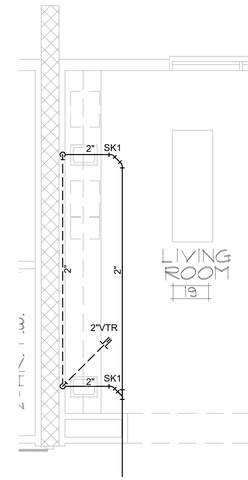

6 **PARTIAL WASTE-VENT PLAN**
1/4" = 1'-0"

PLAN NORTH

CBHF Engineers, PLLC
2246 Yaupon Drive Phone: 910.791.4000
Wilmington, NC 28401 Fax: 910.791.5266
www.cbhfengineers.com
NC# P-0506
© Copyright 2026 CBHF Engineers, PLLC

NORTH CAROLINA PROFESSIONAL SEAL 10592 ENGINEER JAMES R. PENSON
09/25/2026

09-29-2026 BID

PRUITTHEALTH
FORSYTH COUNTY, L.L.C.
Winston-Salem, North Carolina

David R. Polston - Architect
3806 Park Ave. Suite 2-L, Wilmington, NC 28403
Architecture Planning Design

REV	DESCR	DATE
1	REVISIONS PER PLAN REVIEW	08.21.2026

100 BED FACILITY
PLUMBING ENLARGED WASTE-VENT PLANS


PS 1.8

CBHF
Engineers, PLLC
2246 Yaupon Drive Phone: 910.791.4000
Wilmington, NC 28401 Fax: 910.791.5266
www.cbhfengineers.com
NC# P-0506
© Copyright 2026 CBHF Engineers, PLLC


NORTH CAROLINA PROFESSIONAL SEAL 10592 ENGINEER JAMES R. POLSTON
09/25/2026

09-29-2026 BID

PRUITTHEALTH
FORSYTH COUNTY, L.L.C.
Winston-Salem, North Carolina

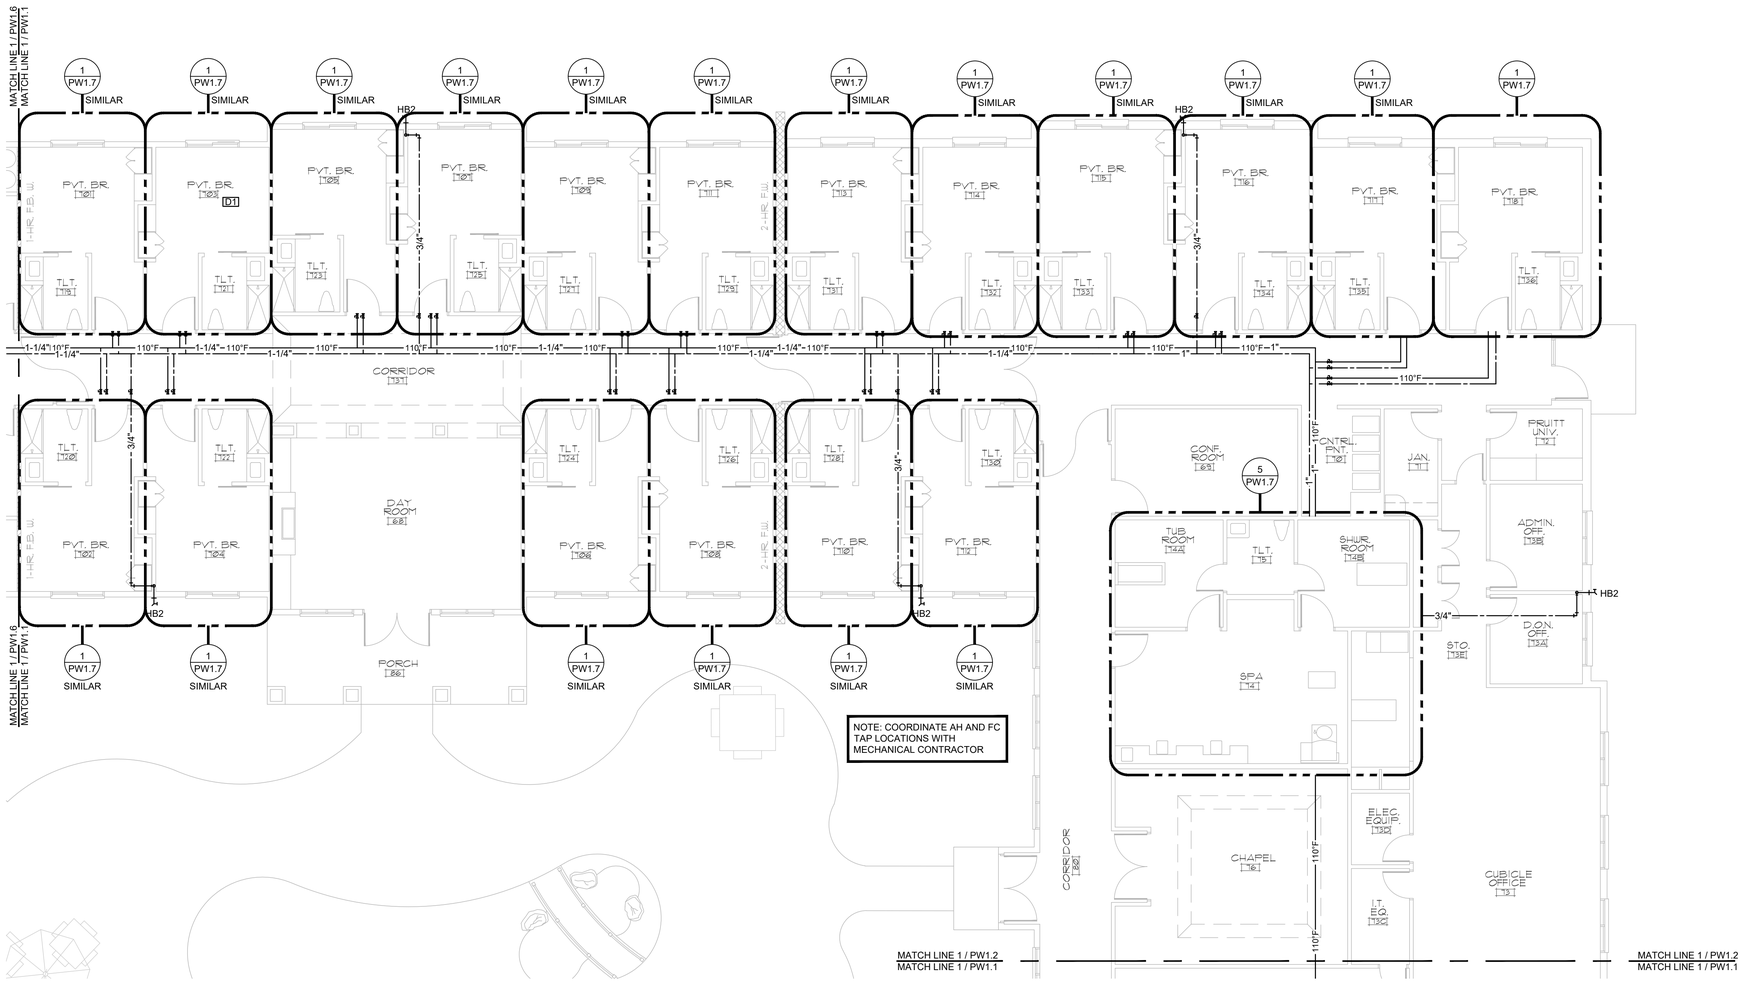

1 PARTIAL DOMESTIC WATER PLAN
1/8" = 1'-0"
0 4' 8' 16'
PLAN NORTH

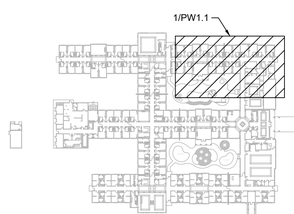


0 KEYPLAN
NOT TO SCALE

David R. Polston - Architect
3806 Park Ave. Suite 2-L, Wilmington, NC 28403
Architecture Planning Design

100 BED FACILITY
PLUMBING PARTIAL DOMESTIC WATER PLAN

PW 1.1

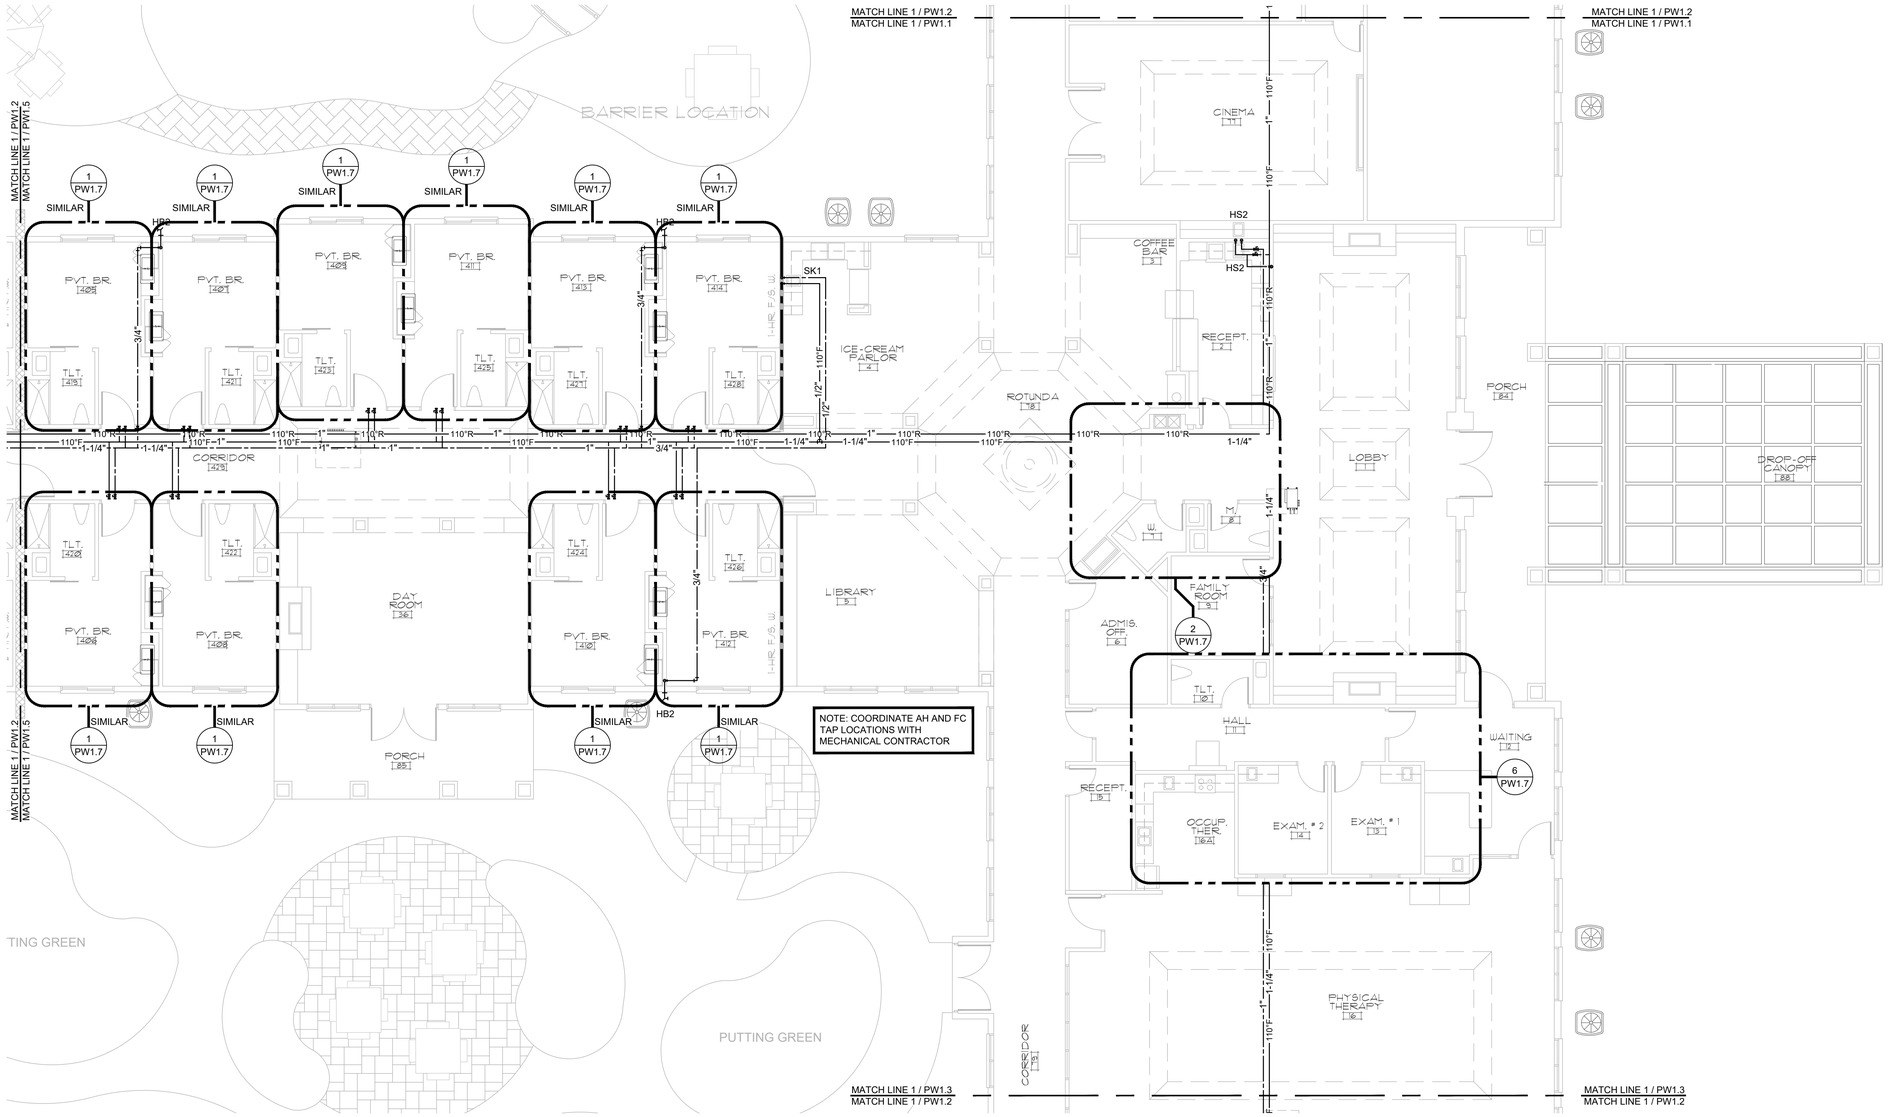


1 PARTIAL DOMESTIC WATER PLAN

1/8" = 1'-0"

0 4' 8' 16'

PLAN NORTH

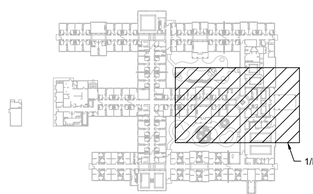

0 KEYPLAN

NOT TO SCALE

CBHF
Engineers, PLLC
2246 Yaupon Drive Phone: 910.791.4000
Wilmington, NC 28401 Fax: 910.791.5266
www.cbhfengineers.com
NC# P-0506
© Copyright 2026 CBHF Engineers, PLLC

NORTH CAROLINA PROFESSIONAL SEAL 10592 ENGINEER JAMES R. POLSTON

09/25/2026


09-29-2026 BID

PRUITTHEALTH
FORSYTH COUNTY, L.L.C.
Winston-Salem, North Carolina

David R. Polston - Architect
3806 Park Ave. Suite 2-L, Wilmington, NC 28403
Architecture Planning Design


100 BED FACILITY
PLUMBING PARTIAL DOMESTIC WATER PLAN

PW 1.2

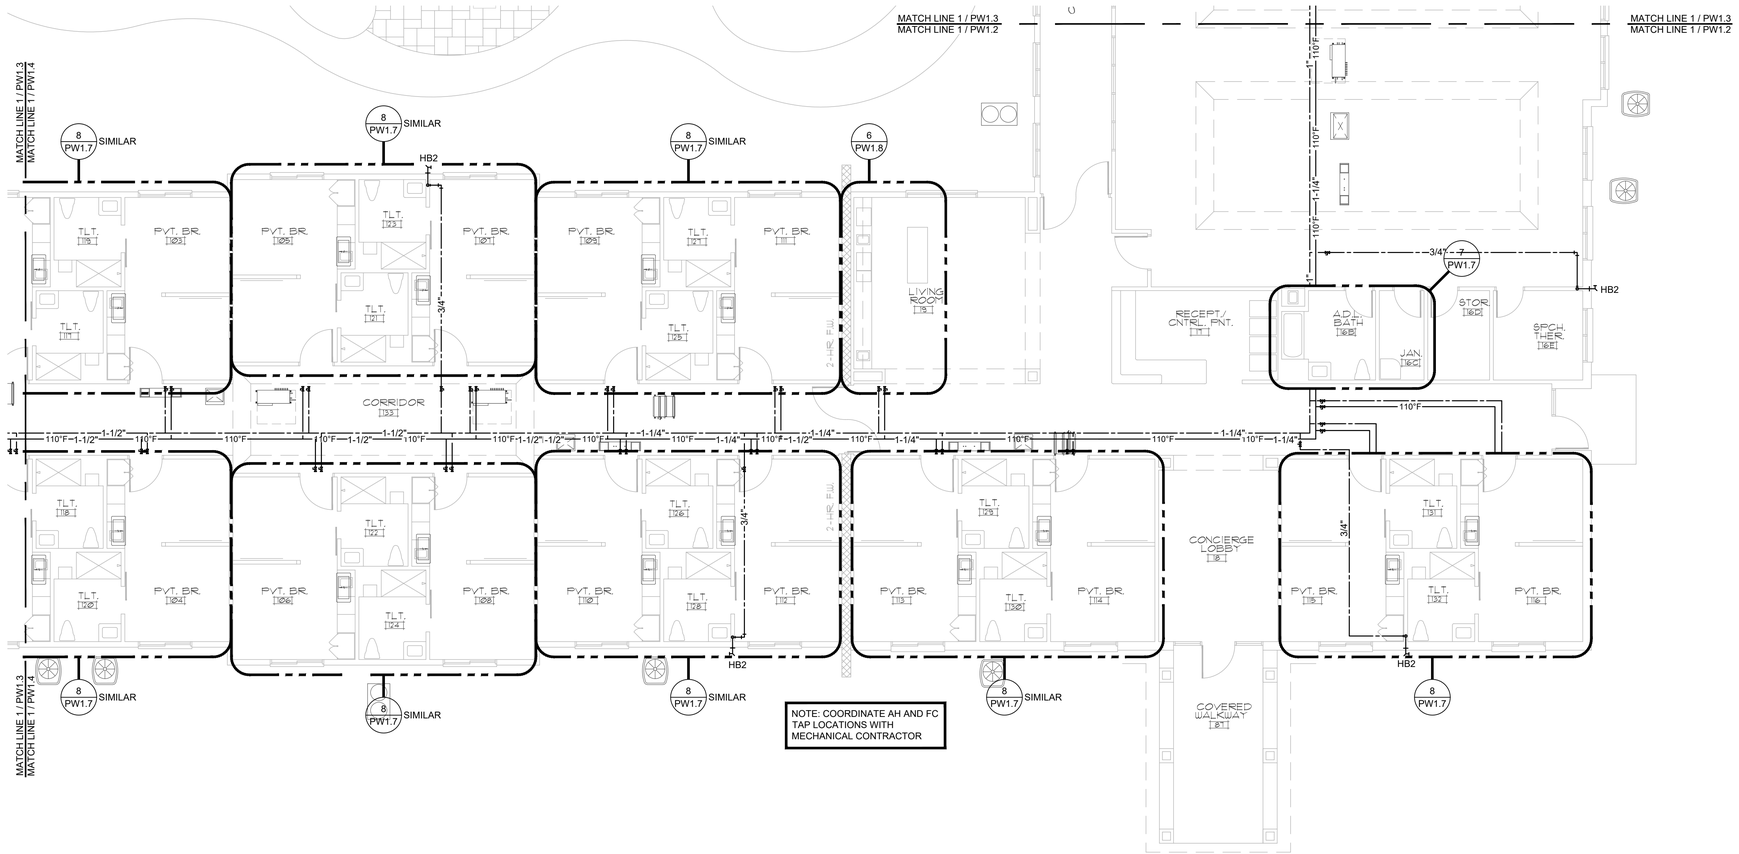

1 **PARTIAL DOMESTIC WATER PLAN**
1/8" = 1'-0"
0 4" 8" 16"

PLAN NORTH

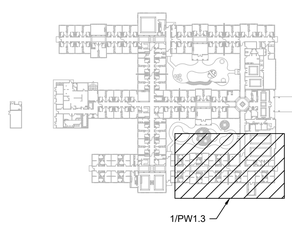

0 **KEYPLAN**
NOT TO SCALE

CBHF
Engineers, PLLC
2246 Yaupon Drive Phone: 910.791.4000
Wilmington, NC 28401 Fax: 910.791.5266
www.cbhfengineers.com
© Copyright 2026 CBHF Engineers, PLLC
NC# P-0506

NORTH CAROLINA PROFESSIONAL SEAL 10592 ENGINEER JAMES R. POLSTON

09/25/2026

09-29-2026 BID


PRUITTHEALTH
FORSYTH COUNTY, L.L.C.
Winston-Salem, North Carolina

David R. Polston - Architect
3806 Park Ave. Suite 2-L, Wilmington, NC 28403
Architecture Planning Design


100 BED FACILITY
PLUMBING PARTIAL
DOMESTIC WATER PLAN

PW 1.3

CBHF
Engineers, PLLC
2246 Yaupon Drive Phone: 910.791.4000
Wilmington, NC 28401 Fax: 910.791.5266
www.cbhfengineers.com
NC# P-0506
© Copyright 2026 CBHF Engineers, PLLC

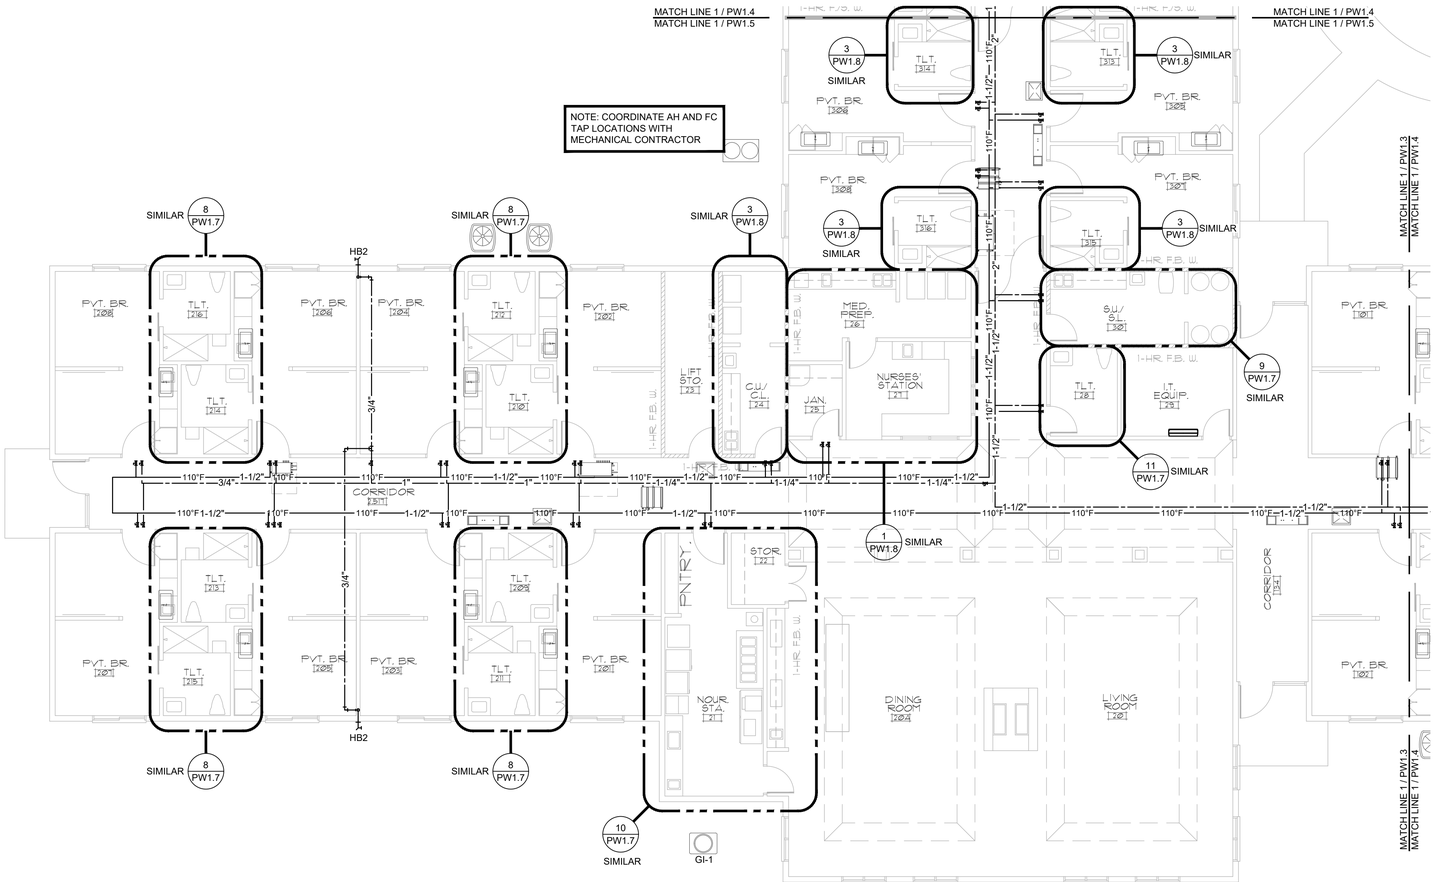

1 **PARTIAL DOMESTIC WATER PLAN**
1/8" = 1'-0"
0 4' 8' 16'
PLAN NORTH

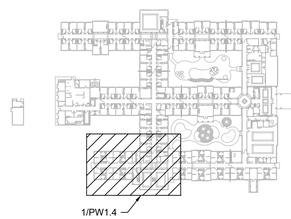

0 **KEYPLAN**
NOT TO SCALE

NORTH CAROLINA PROFESSIONAL SEAL 10592 ENGINEER JAMES R. POLSTON
09/25/2026

09-29-2026 BID

PRUITTHEALTH
FORSYTH COUNTY, L.L.C.
Winston-Salem, North Carolina

David R. Polston - Architect
3806 Park Ave. Suite 2-L, Wilmington, NC 28403
Architecture Planning Design

100 BED FACILITY
PLUMBING PARTIAL
DOMESTIC WATER PLAN

PW 1.4

CBHF
Engineers, PLLC
2246 Yaupon Drive Phone: 910.791.4000
Wilmington, NC 28401 Fax: 910.791.5266
www.cbhfengineers.com
NC# P-0506
© Copyright 2026 CBHF Engineers, PLLC

NORTH CAROLINA PROFESSIONAL SEAL 10592 ENGINEER JAMES R. POLSTON
09/25/2026


09-29-2026 BID

David R. Polston - Architect
3806 Park Ave. Suite 2–L, Wilmington, NC 28403
Architecture Planning Design

PRUITTHEALTH
FORSYTH COUNTY, L.L.C.
Winston–Salem, North Carolina

100 BED FACILITY
PLUMBING PARTIAL DOMESTIC WATER PLAN

PW 1.5

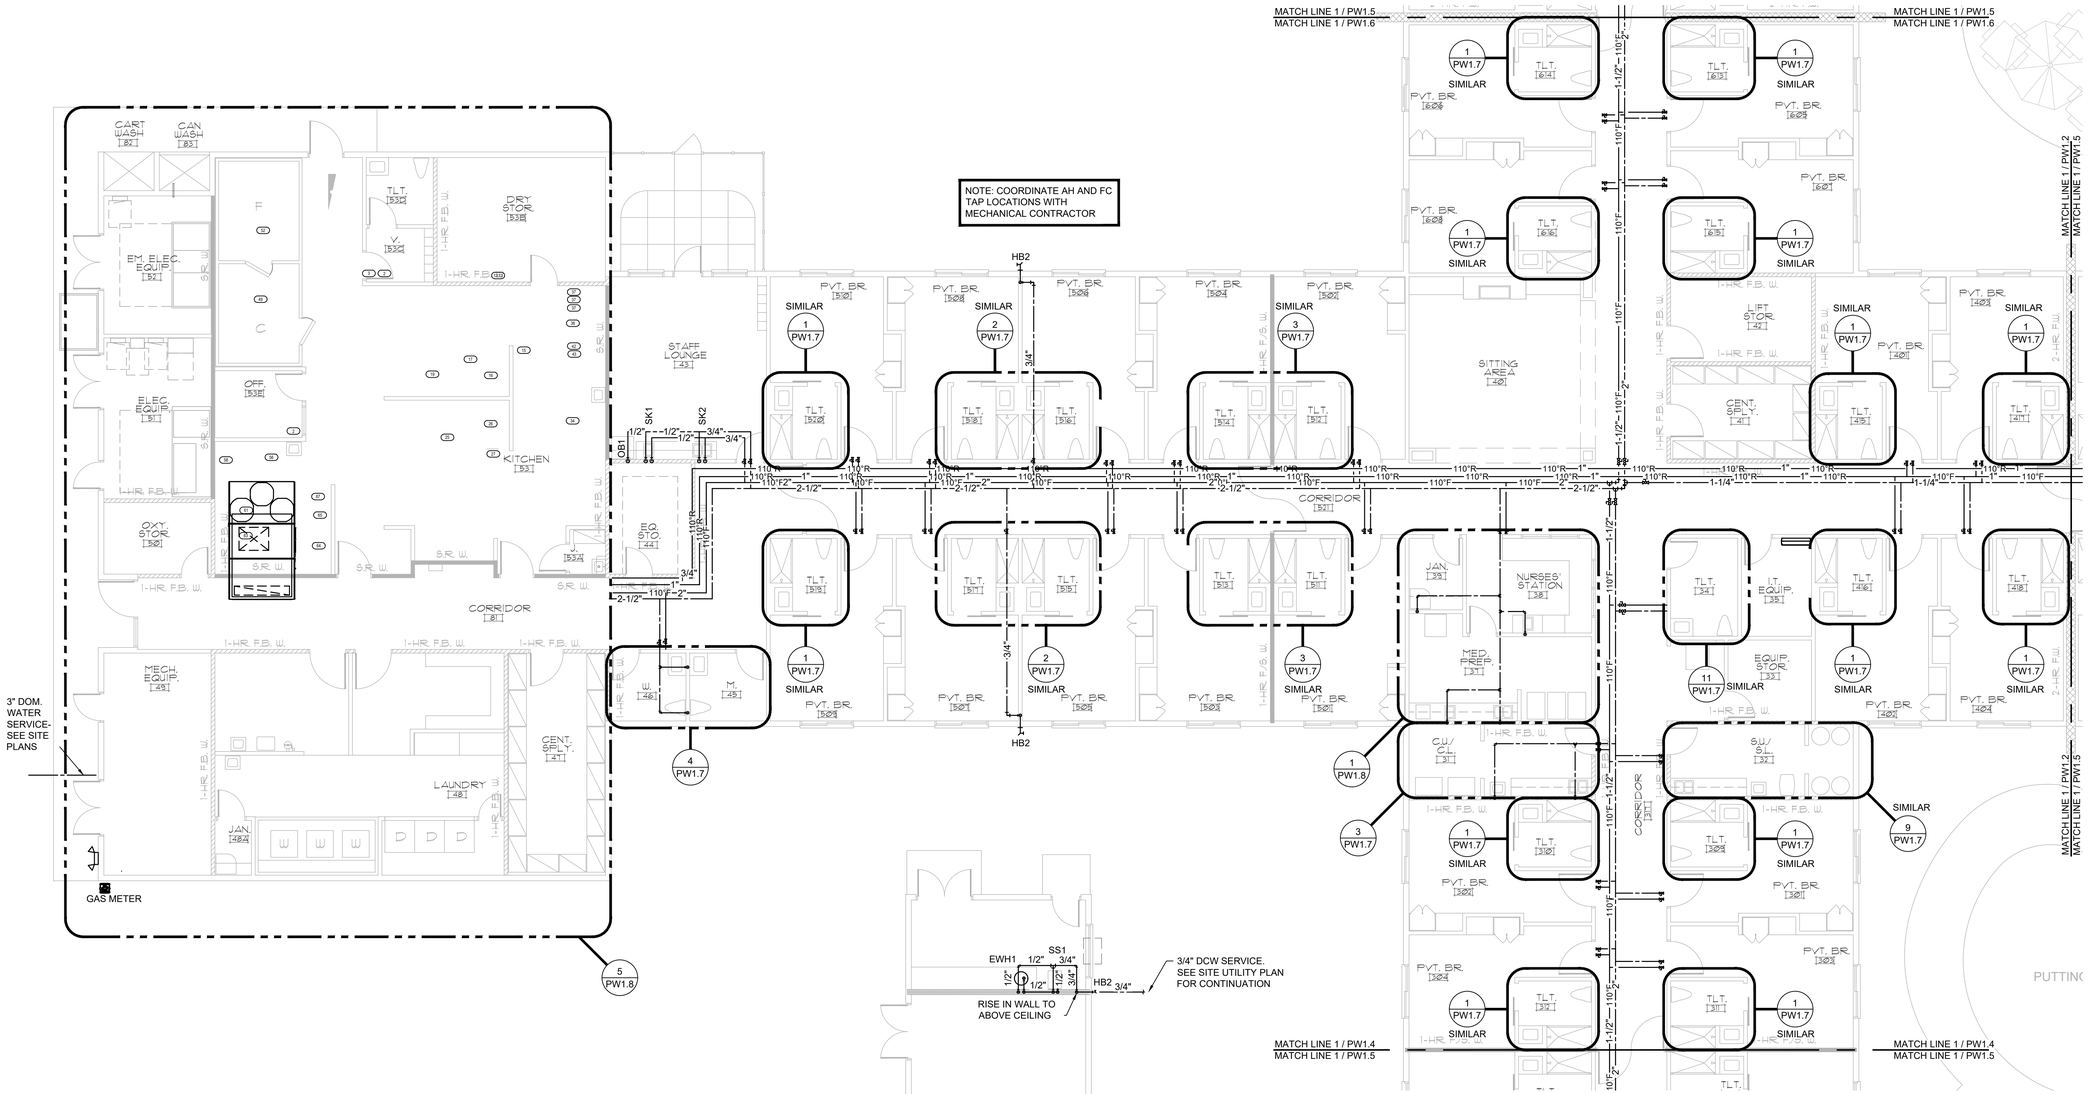

1 PARTIAL DOMESTIC WATER PLAN

1/8" = 1'-0"

PLAN NORTH

2 MAINTENANCE BLDG. DOMESTIC WATER PLAN

1/8" = 1'-0"


PLAN NORTH

0 KEYPLAN

NOT TO SCALE

CBHF
Engineers, PLLC
2246 Yaupon Drive Phone: 910.791.4000
Wilmington, NC 28401 Fax: 910.791.5266
www.cbhfengineers.com
NC# P-0506
© Copyright 2026 CBHF Engineers, PLLC

NOTE: COORDINATE AH AND FC TAP LOCATIONS WITH MECHANICAL CONTRACTOR

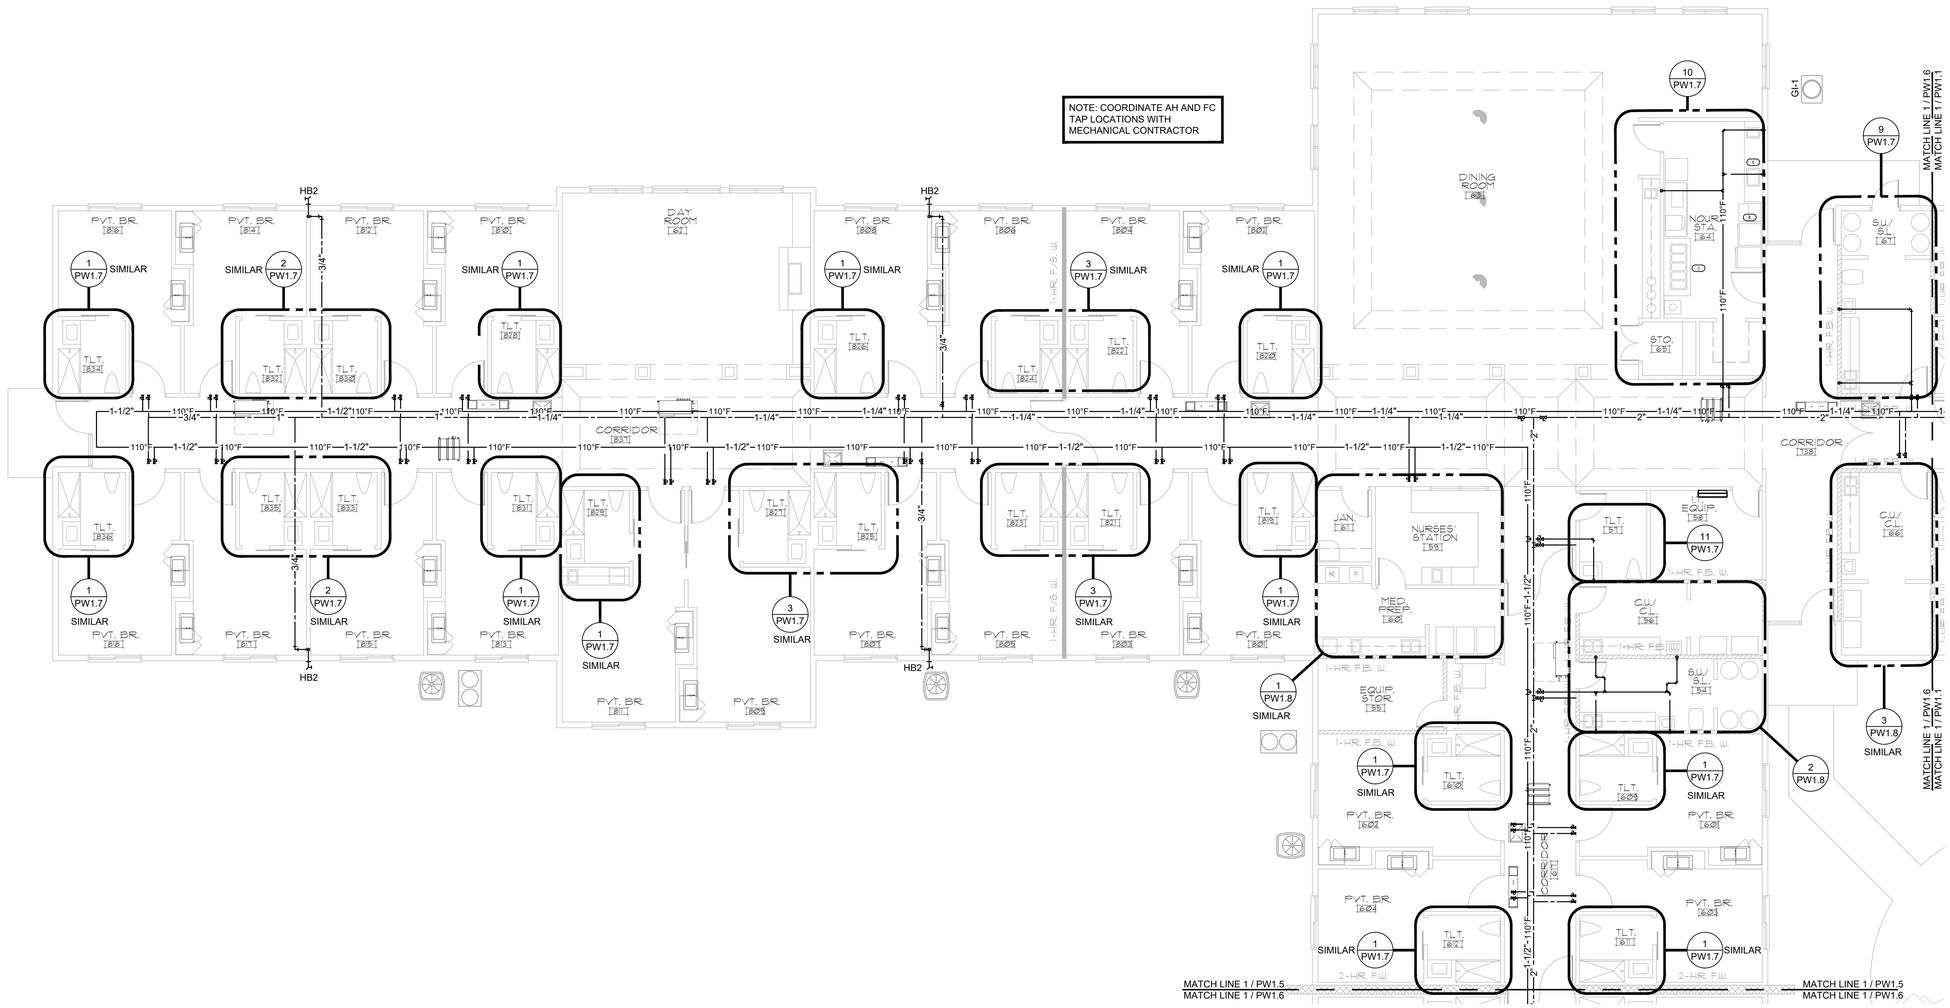


1 PARTIAL DOMESTIC WATER PLAN

1/8" = 1'-0"

0 4' 8' 16'

PLAN NORTH

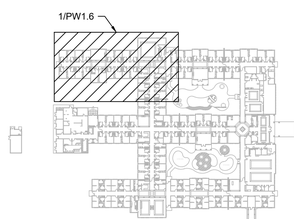

0 KEYPLAN
NOT TO SCALE

NORTH CAROLINA PROFESSIONAL ENGINEER SEAL 10592 JAMES R. POLSTON
09/25/2026


09-29-2026 BID

David R. Polston - Architect
3806 Park Ave. Suite 2–L, Wilmington, NC 28403
Architecture Planning Design


PRUITTHEALTH
FORSYTH COUNTY, L.L.C.
Winston–Salem, North Carolina

100 BED FACILITY
PLUMBING PARTIAL
DOMESTIC WATER PLAN


PW 1.6

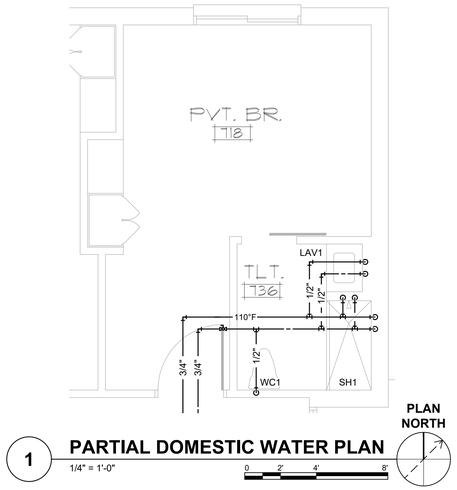


1 PARTIAL DOMESTIC WATER PLAN
1/4" = 1'-0"
PLAN NORTH

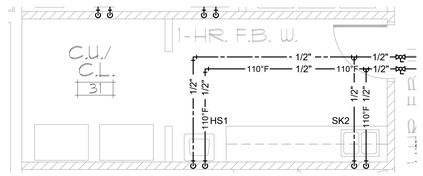


3 PARTIAL DOMESTIC WATER PLAN
1/4" = 1'-0"
PLAN NORTH

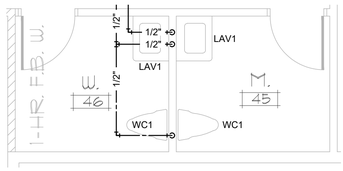


4 PARTIAL DOMESTIC WATER PLAN
1/4" = 1'-0"
PLAN NORTH

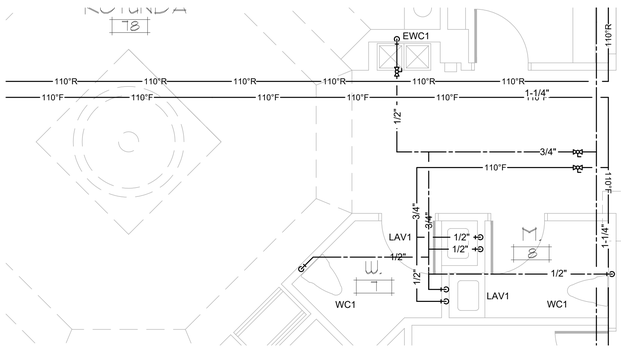


2 PARTIAL DOMESTIC WATER PLAN
1/4" = 1'-0"
PLAN NORTH

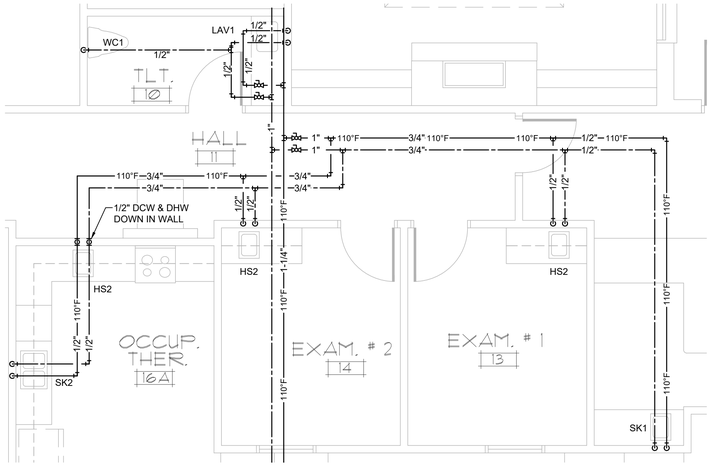


6 PARTIAL DOMESTIC WATER PLAN
1/4" = 1'-0"
PLAN NORTH

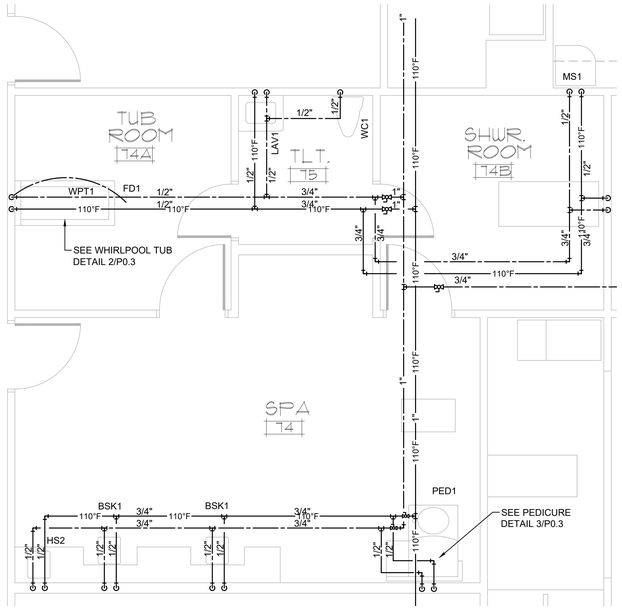


5 PARTIAL DOMESTIC WATER PLAN
1/4" = 1'-0"
PLAN NORTH

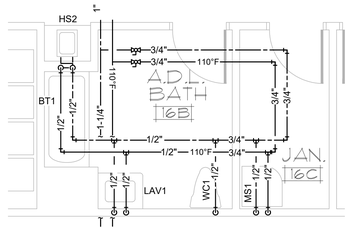


7 PARTIAL DOMESTIC WATER PLAN
1/4" = 1'-0"
PLAN NORTH

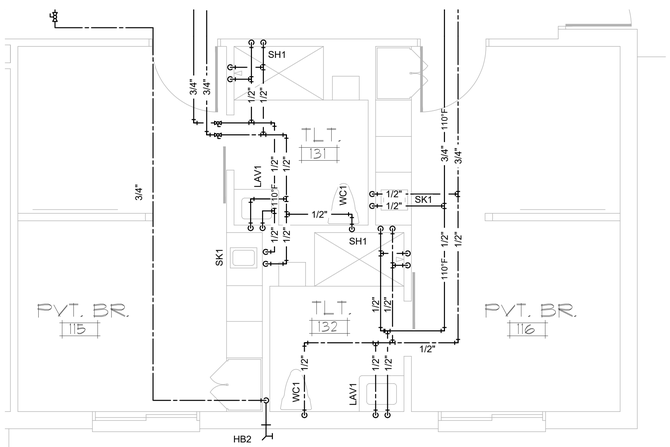


8 PARTIAL DOMESTIC WATER PLAN
1/4" = 1'-0"
PLAN NORTH

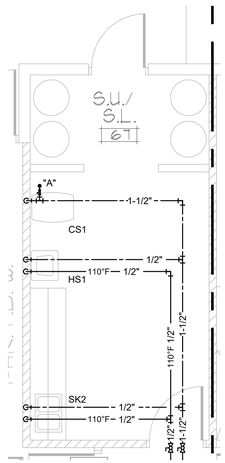

9 PARTIAL DOMESTIC WATER PLAN
1/4" = 1'-0"
PLAN NORTH

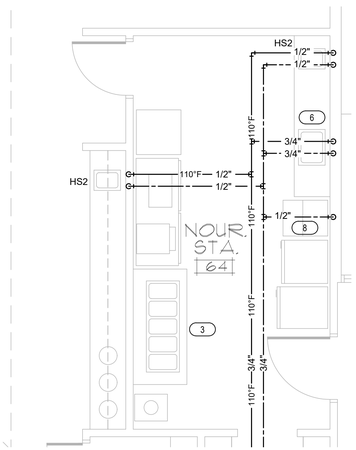

10 PARTIAL DOMESTIC WATER PLAN
1/4" = 1'-0"
PLAN NORTH

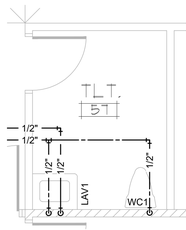

11 PARTIAL DOMESTIC WATER PLAN
1/4" = 1'-0"
PLAN NORTH

CBHF
Engineers, PLLC
2246 Yaupon Drive Phone: 910.791.4000
Wilmington, NC 28401 Fax: 910.791.5266
www.cbhfengineers.com
NC# P-0506
© Copyright 2026 CBHF Engineers, PLLC

NORTH CAROLINA PROFESSIONAL ENGINEER SEAL 10592 JAMES R. BENSON
09/25/2026

09-29-2026 BID

PRUITTHEALTH
FORSYTH COUNTY, L.L.C.
Winston-Salem, North Carolina

David R. Polston - Architect
3806 Park Ave. Suite 2-L, Wilmington, NC 28403
Architecture Planning Design

100 BED FACILITY
PLUMBING ENLARGED DOMESTIC WATER PLANS


PW 1.7

CBHF
Engineers, PLLC
2246 Yaupon Drive Phone: 910.791.4000
Wilmington, NC 28401 Fax: 910.791.5266
www.cbhfengineers.com
NC# P-0506
© Copyright 2026 CBHF Engineers, PLLC


NORTH CAROLINA PROFESSIONAL ENGINEER SEAL 10592 JAMES R. BENSON

09/25/2026


09-29-2026 BID

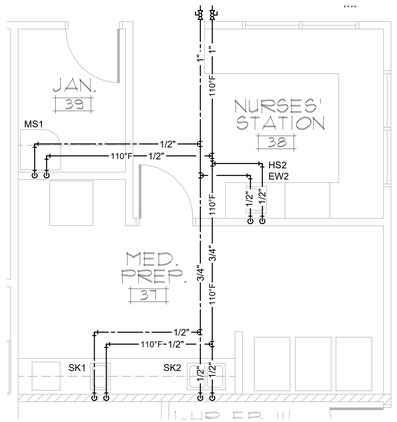


1 **PARTIAL DOMESTIC WATER PLAN**
1/4" = 1'-0"
PLAN NORTH

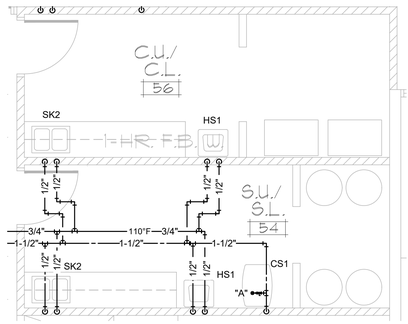


2 **PARTIAL DOMESTIC WATER PLAN**
1/4" = 1'-0"
PLAN NORTH

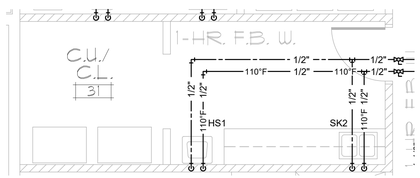


3 **PARTIAL DOMESTIC WATER PLAN**
1/4" = 1'-0"
PLAN NORTH

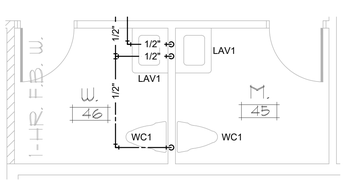

4 **PARTIAL DOMESTIC WATER PLAN**
1/4" = 1'-0"
PLAN NORTH

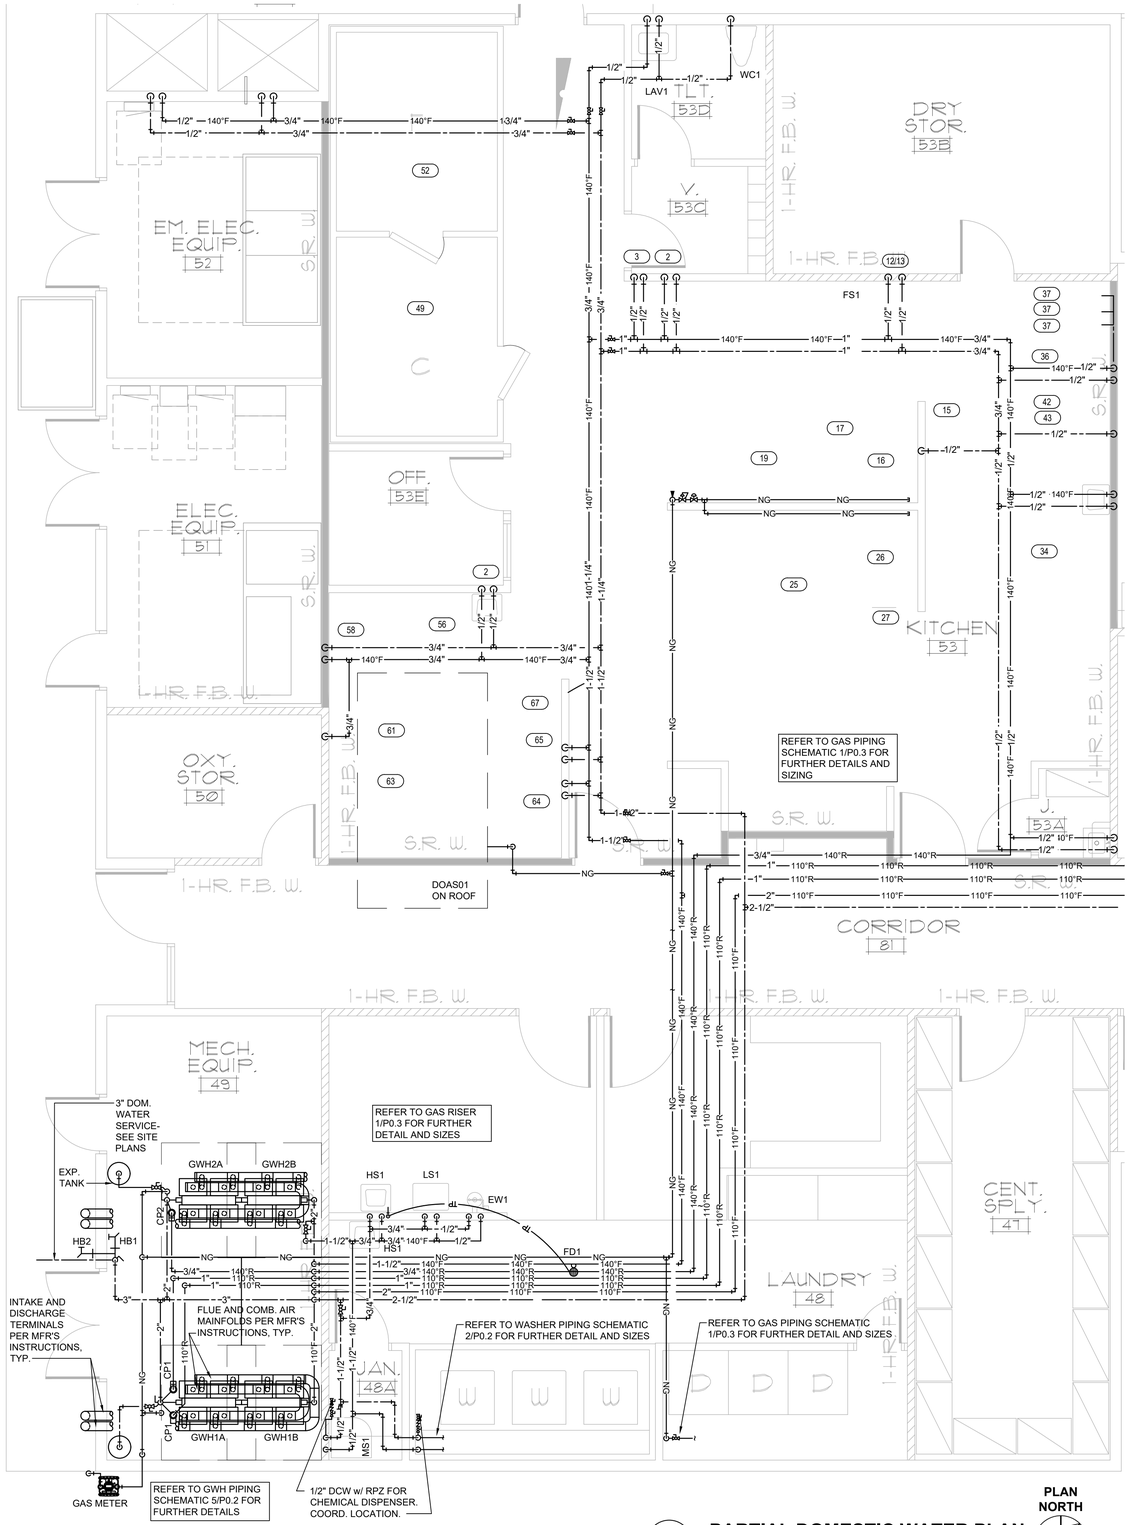

5 **PARTIAL DOMESTIC WATER PLAN**
1/4" = 1'-0"
PLAN NORTH

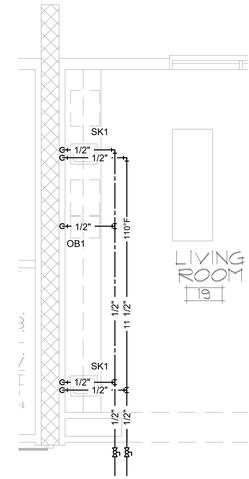

6 **PARTIAL DOMESTIC WATER PLAN**
1/4" = 1'-0"
PLAN NORTH

PRUITTHEALTH
FORSYTH COUNTY, L.L.C.
Winston-Salem, North Carolina

David R. Polston - Architect
3806 Park Ave. Suite 2-L, Wilmington, NC 28403
Architecture Planning Design

100 BED FACILITY
PLUMBING ENLARGED DOMESTIC WATER PLANS

PW 1.8